

# STATE OF TEXAS DEPARTMENT OF TRANSPORTATION

## PLANS OF COMPLETED STATE HIGHWAY IMPROVEMENT

FEDERAL AID PROJECT BR 95(161), etc.

U.S. HWY. 90 LIBERTY COUNTY

LIMITS: FROM 0.38 MILES EAST OF TRINITY RIVER IN LIBERTY  
TO 0.15 MILES EAST OF FM HWY. 1409 IN DAYTON

FOR THE CONSTRUCTION OF THE UPGRADING OF A NON-FREEWAY FACILITY  
CONSISTING OF REPLACING STRUCTURES, WIDEN STRUCTURES, GRADING  
CONC. PAV., CEM. STAB. BASE, ASPH. STAB. BASE, LIME TREAT. SUBG.  
SAFETY FEATURES, SURF. TREAT., ACP, PAVEMENT MARKINGS AND SIGNING


NET LENGTH OF PROJECT = 23,800 FT. = 4.507 MI.  
ROADWAY 19,352.34 FT. = 3.665 MI.  
BRIDGES 4,447.66 FT. = 0.842 MI.

FED. AID DIST. NO.	STATE	FEDERAL AID PROJECT NO.	SHEET NO.
05	TEXAS	BR 95(161), etc.	1
STATE DIST. NO.	COUNTY	CONTRACT NO.	HIGHWAY NO.
20	LIBERTY	0028-03-081, etc.	U.S. 90

RES. NO. 054

DESIGN SPEED 45 MPH (URBAN)  
DESIGN SPEED 70 MPH (RURAL)

\*DESIGN SPEED FOR TRANSITIONS BETWEEN  
URBAN AND RURAL SECTIONS WILL BE 60MPH.

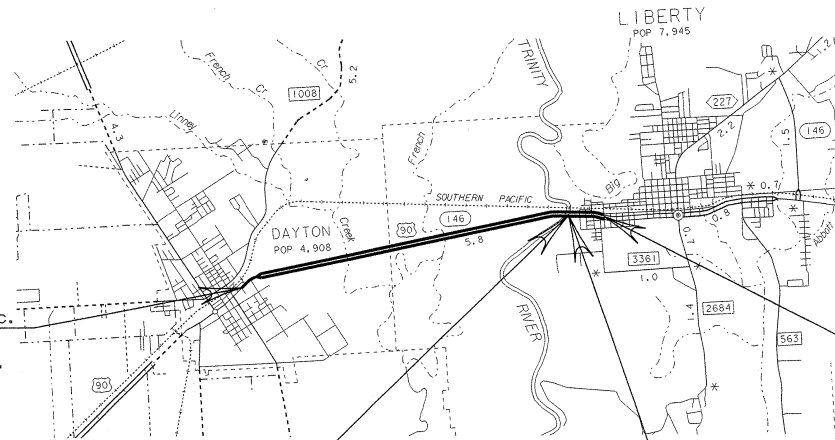

END PROJECT BR 95(161), etc.  
STA. 1417+00 (G)  
CONTROL 0028-03-081, etc.  
REF. MRK. = 874+1.886

BEGIN PROJECT BR 95(161), etc.  
STA. 1199+09 (G)  
CONTROL 0028-03-081, etc.  
REF. MRK. = 876+0.291

END PROJECT  
STA. 1199+09 (G)  
CONTROL 0028-04-063  
REF. MRK. = 876+0.291

### "FINAL PLANS"

PROJECT BEGAN (ACTUAL WORK BEGAN)	SEPTEMBER 9, 1996
PROJECT COMPLETED	AUGUST 18, 2000
PROJECT CONSTRUCTED & FINAL PLANS BY:	E.P. Szymanski
FINAL CONTRACT COST	\$ 15,507,365.22

*E.P. Szymanski*

BEGIN PROJECT  
STA. 1179+00 (G)  
CONTROL 0028-04-063  
REF. MRK. = 876+0.671

THE CONTRACTOR SHALL PROVIDE AND ERECT BARRICADES AND  
CONSTRUCTION SIGNS IN ACCORDANCE WITH BC (11-9)94 AND  
THE "TEXAS MANUAL ON UNIFORM TRAFFIC CONTROL DEVICES AT  
POINTS AS SHOWN ON THE TITLE SHEET AND PLAN SHEETS AND  
AS DIRECTED BY THE ENGINEER.

SPECIFICATIONS ADOPTED BY THE TEXAS DEPARTMENT OF  
TRANSPORTATION, MARCH 1, 1993 AND SPECIFICATION ITEMS  
LISTED AND DATED AS FOLLOWS, SHALL GOVERN ON THIS PROJECT, REQUIRED  
CONTRACT PROVISIONS FOR ALL FEDERAL-AID CONSTRUCTION CONTRACTS  
(FORM FHWA 1273, DECEMBER 1993)

NO EQUATIONS  
EXCEPTION: RAILROAD  
STA. 1190+46.74 TO STA. 1190+55.74 (A) = 9.0'

LAYOUT SCALE: 1 IN. = 3/4 MILE





CORRECT: 12/18/95  
RECOMMENDED FOR LETTING: 12/18/95  
RECOMMENDED FOR LETTING: 12/22/95  
DISTRICT ENGINEER

APPROVED FOR LETTING: [Signature]  
DIRECTOR OF BRIDGES AND STRUCTURES  
APPROVED FOR LETTING: [Signature]  
APPROVED FOR LETTING: [Signature]  
DIRECTOR, DIVISION

U.S. DEPARTMENT OF TRANSPORTATION  
FEDERAL HIGHWAY ADMINISTRATION  
APPROVED: [Signature]  
DIVISION ADMINISTRATOR DATE

COUNTY: LIBERTY PROJ. NO. BR 95(161), etc.  
DATE: 12/18/95  
DATE ACCEPTED: 12/22/95

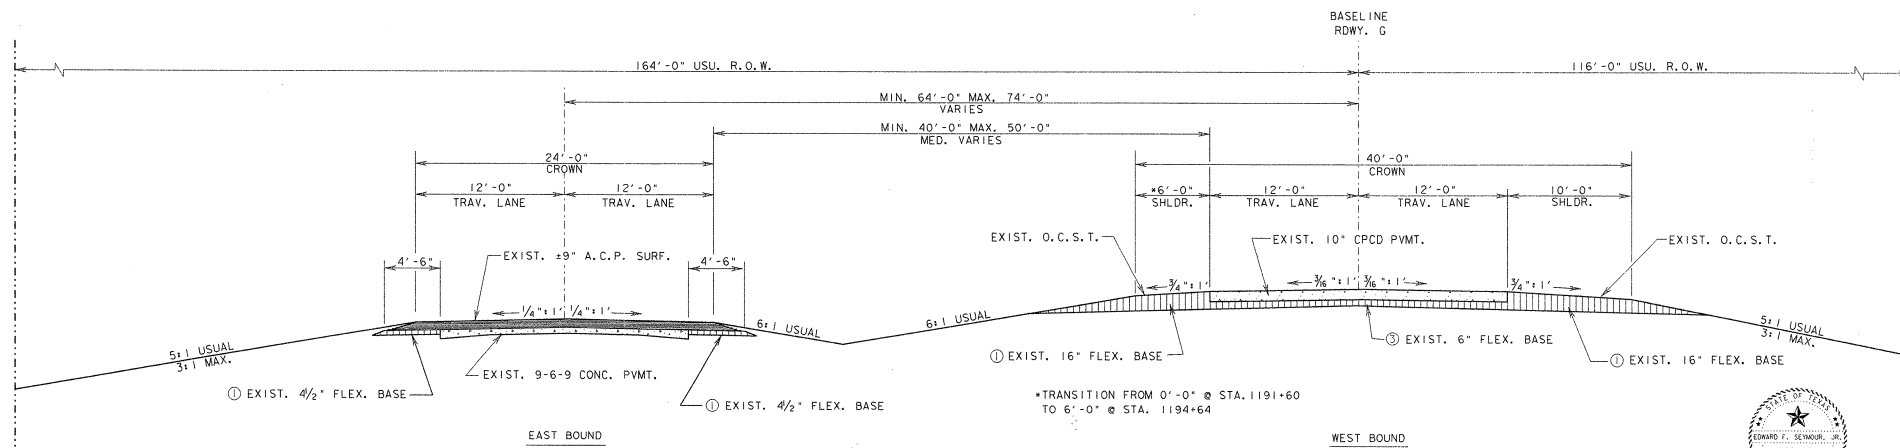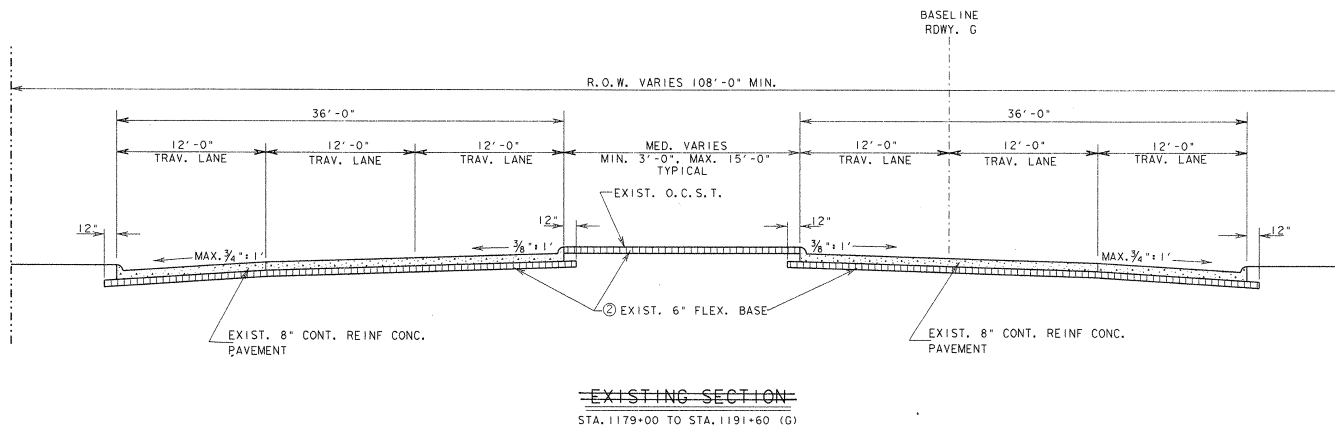

- ① ~~PROP.~~ REWORK BASE MATL. (TY. C)  
LIMITS SHOWN ON PLAN PROFILE SHEETS.
- \*\*② ~~PROP.~~ REWORK BASE MATL. (TY. B)  
LIMITS SHOWN ON PLAN PROFILE SHEETS.
- \*\*③ ~~PROP.~~ REWORK BASE MATL. (TY. B)  
FROM STA. 1191+60 TO STA. 1199+27.99 (G)  
THE REMAINING AREAS SHOWN ON THE  
PLAN PROFILE SHEETS WILL BE (TY. C).

SALV. FLEX BASE TO BE USED TO FILL  
\*\* IN MEDIAN & CONSTRUCT BOAT RAMP  
ACCESS ROAD.

EXISTING SECTION  
STA. 1191+60 TO STA. 1404+57 (G)  
TOTAL EXIST. BRIDGE LENGTHS EAST BOUND = 4339.75'  
TOTAL EXIST. BRIDGE LENGTHS WEST BOUND = 4340.68'



## TYPICAL CROSS SECTIONS

U.S. HWY. 90



The seal appearing on  
this document was  
authorized by  
Edward F. Seymour, Jr.,  
P.E. 25415, on  
12/18, 1995

FED. ROAD DIST. NO.	STATE	FEDERAL AID PROJECT NO.	SHEET NO.
6	TEXAS	BR 95(161), etc.	2
STATE DIST. NO.	COUNTY	CONTRACT NO.	SECTION NO.
20	LIBERTY	0028 03	001

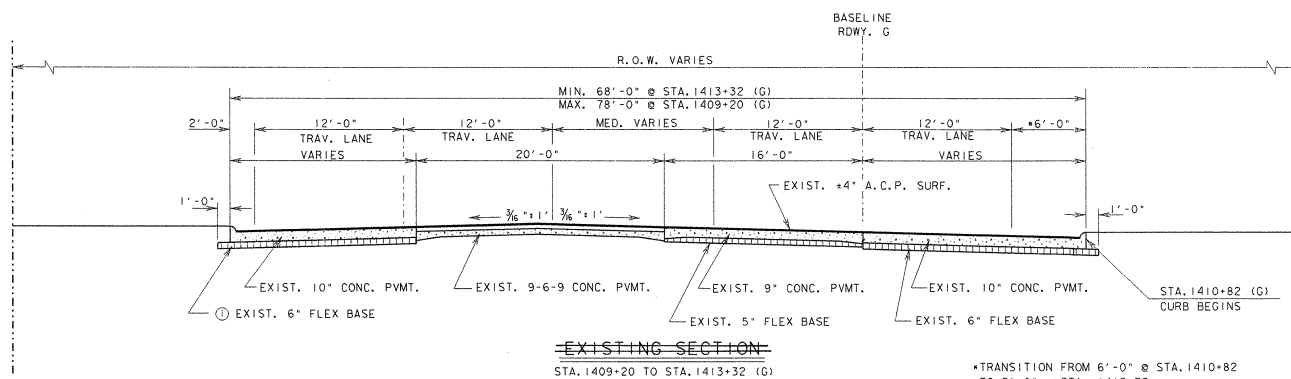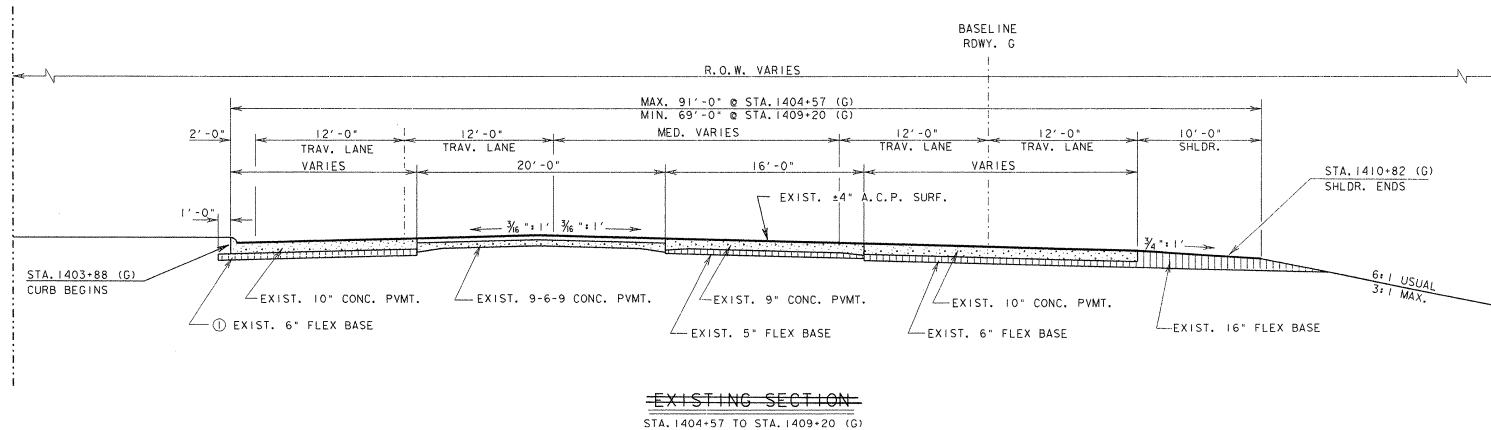

① ~~PROP.~~ REWORK BASE MATL. (TY. C)  
LIMITS SHOWN ON PLAN PROFILE SHEETS.

## TYPICAL CROSS SECTIONS


U.S. HWY. 90



The seal appearing on  
this document was  
authorized by  
Edward F. Seymour, Jr.,  
P.E. 25415, on  
12/15, 1995


*Edward F. Seymour, Jr.*

STATE	FEDERAL AID PROJECT NO.	SHEET NO.
6 TEXAS	BR 95(161), etc.	3
COUNTY	CONTRACT NO.	SECTION NO.
LIBERTY	0028 03	001
		US 90

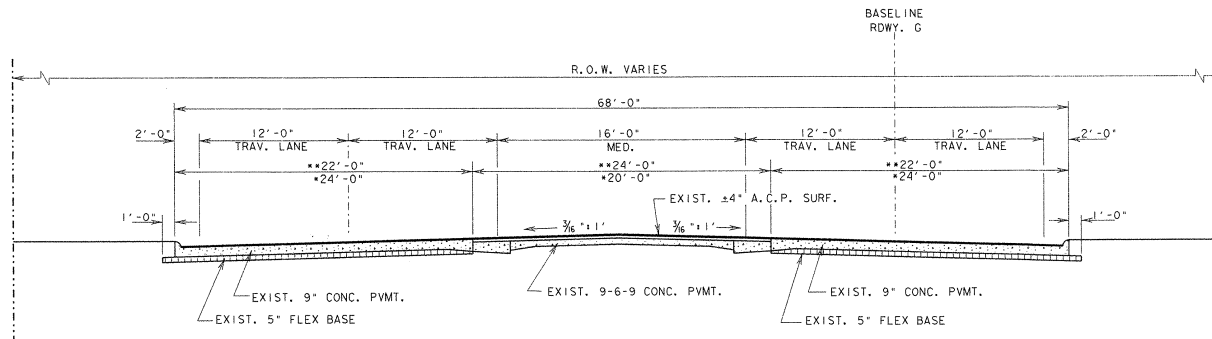

# EXISTING SECTION

\*STA. 1413+32 TO STA. 1414+36 (G)  
 \*\*STA. 1414+36 TO STA. 1417+00 (G)

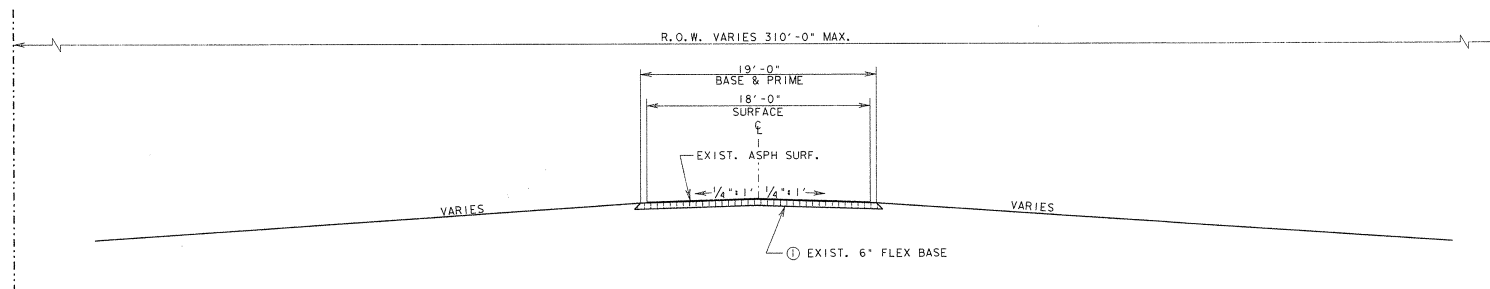

# EXISTING SECTION AT BOAT RAMP ACCESS ROAD

STA. 0+00 TO STA. 12+00 (D)

① ~~PROP.~~ REWORK BASE MATL. (TY. C)  
 LIMITS SHOWN ON PLAN PROFILE SHEETS.

## TYPICAL CROSS SECTIONS


U.S. HWY. 90






The seal appearing on  
 this document was  
 authorized by  
 Edward F. Seymour, Jr.,  
 P.E., 25415, on  
 12/10/95

*Edward F. Seymour, Jr.*

STATE	COUNTY	FEDERAL AID PROJECT NO.	SHEET NO.
6	TEXAS	BR 95(161), etc.	4
STATE	COUNTY	CONTRACT NO.	SECTION NO.
20	LIBERTY	0028	03

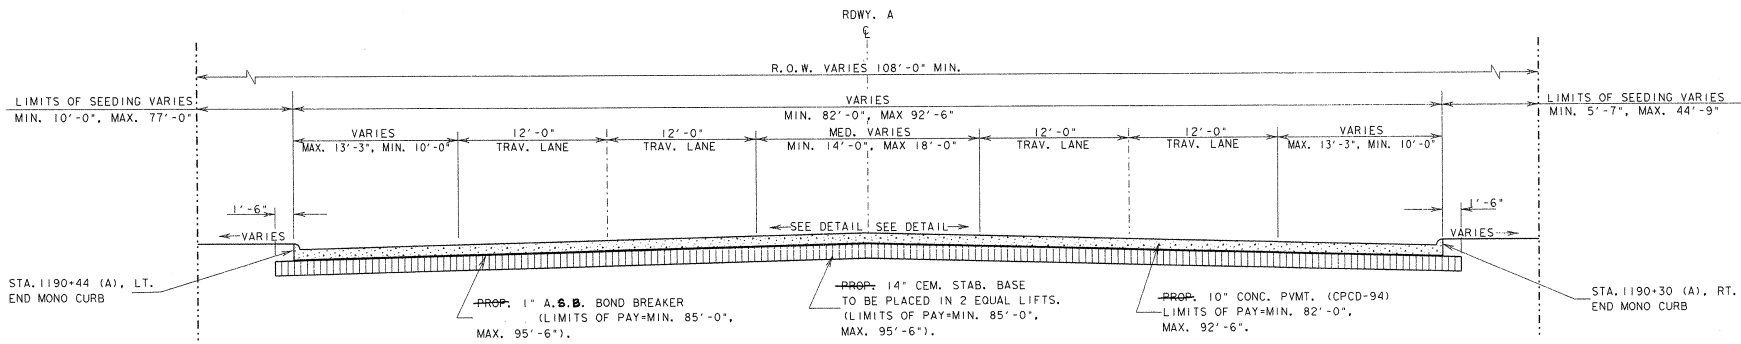

**PROPOSED SECTION**  
TRANSITION STA. 1187+24 TO STA. 1192+60.80 (A)

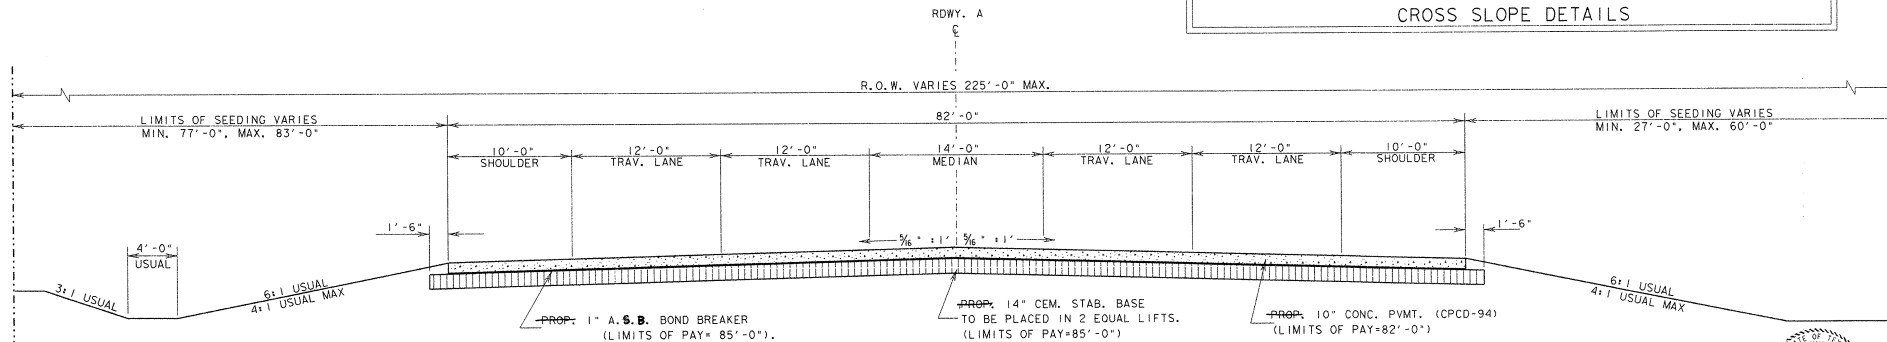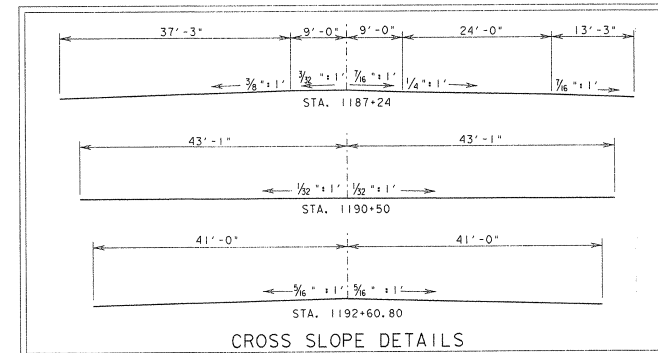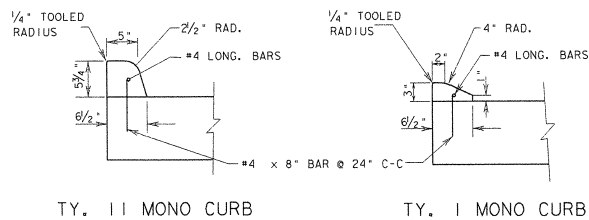

**PROPOSED SECTION**

STA. 1192+60.80 TO STA. 1198+86.17 (A)  
STA. 1213+63.83 TO STA. 1214+39.83 (A)  
(TRINITY RIVER BRIDGE STA. 1198+86.17 TO STA. 1213+63.83 (A))

**MONO CURB NOTES:**

1. REINF. STEEL IS SUBSIDIARY TO ITEM 360.
2. JOINTS IN CURB SHALL BE SPACED TO COINCIDE WITH JOINTS IN THE PAVEMENT. THE JOINTS ARE TO BE FORMED BY PLACING A TEMPLATE CONFORMING TO THE CURB SECTION, REMOVING TEMPLATE AFTER CONCRETE HAS ITS INITIAL SET, THEN GROOVING THE JOINTS.


**TYPICAL CROSS SECTIONS**

U.S. HWY. 90



The seal appearing on this document was authorized by Edward F. Seymour Jr., P.E., 25415, on 12/16/95  
*Edward F. Seymour*


FED. ROAD DIST. NO.	STATE	FEDERAL AID PROJECT NO.	SHEET NO.
6	TEXAS	BR 95(161), etc.	5
STATE DIST. NO.	COUNTY	CONTRACT NO.	SECTION NO.
20	LIBERTY	0028	03
			US 90

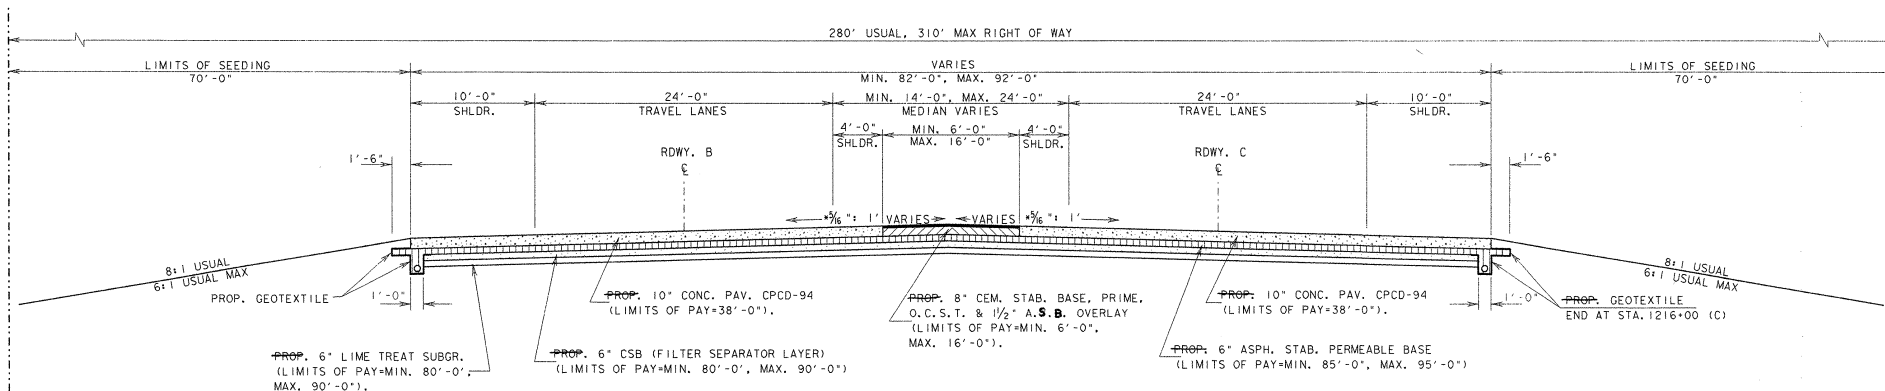


### PROPOSED SECTION

STA. 1214+51.67 TO STA. 1218+79.00 (B)  
STA. 1214+38.44 TO STA. 1218+69.20 (C)

\*CROSS SLOPE VARIES AT CURVE  
SUPERELEVATION & TRANSITION

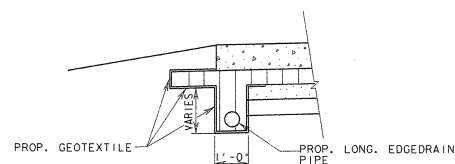

EDGEDRAIN DETAIL  
SEE EDGEDRAIN DETAIL SHEET

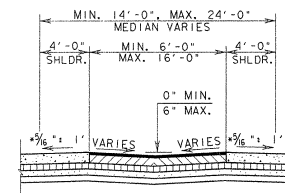


MEDIAN DITCH DETAIL

STA. 1216+35 TO STA. 1218+79.00 (B)  
STA. 1216+22 TO STA. 1218+69.20 (C)



The seal appearing on  
this document was  
authorized by  
Edward F. Seymour, Jr.,  
P.E., 25415, on  
12/18/1995

Edward F. Seymour, Jr.

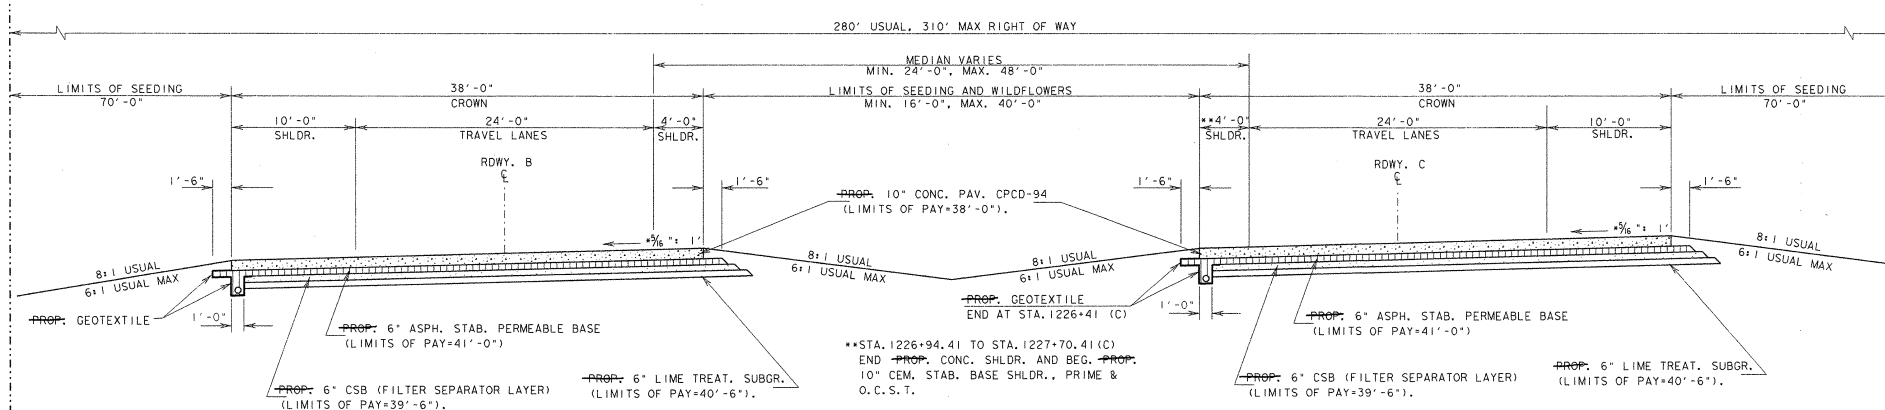

### PROPOSED SECTION



STA. 1218+79.00 TO STA. 1227+63.00 (B)  
STA. 1218+69.20 TO STA. 1227+70.41 (C)

(RELIEF STRUCT. NO. 1 STA. 1227+63.00 TO STA. 1233+57.00 (B))  
(RELIEF STRUCT. NO. 1 STA. 1227+70.41 TO STA. 1233+46.79 (C))

## TYPICAL CROSS SECTIONS

U.S. HWY. 90

FED. AID DIST. NO.	STATE	FEDERAL AID PROJECT NO.	SHEET NO.
6	TEXAS	BR 95(161), etc.	6
STATE DIST. NO.	COUNTY	CONTRACT NO.	HIGHWAY NO.
20	LIBERTY	0028 03	US 90

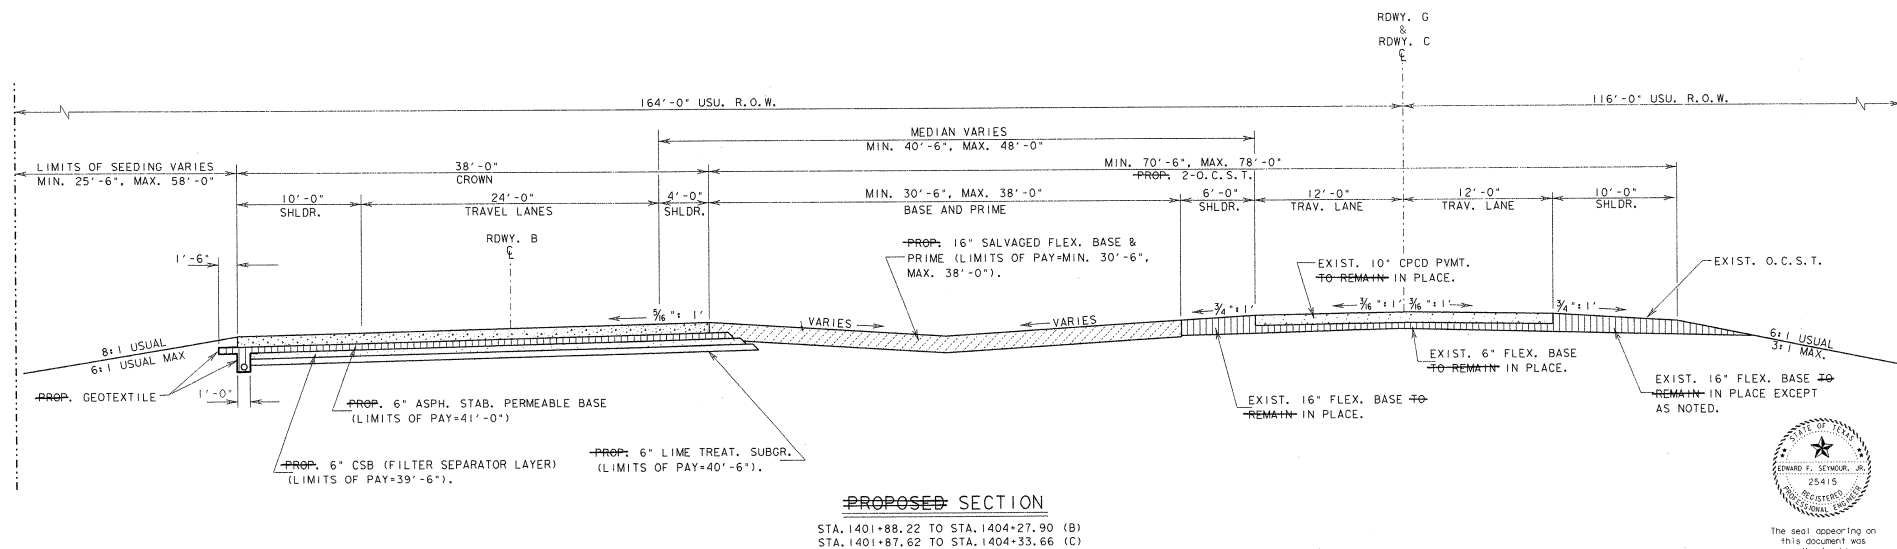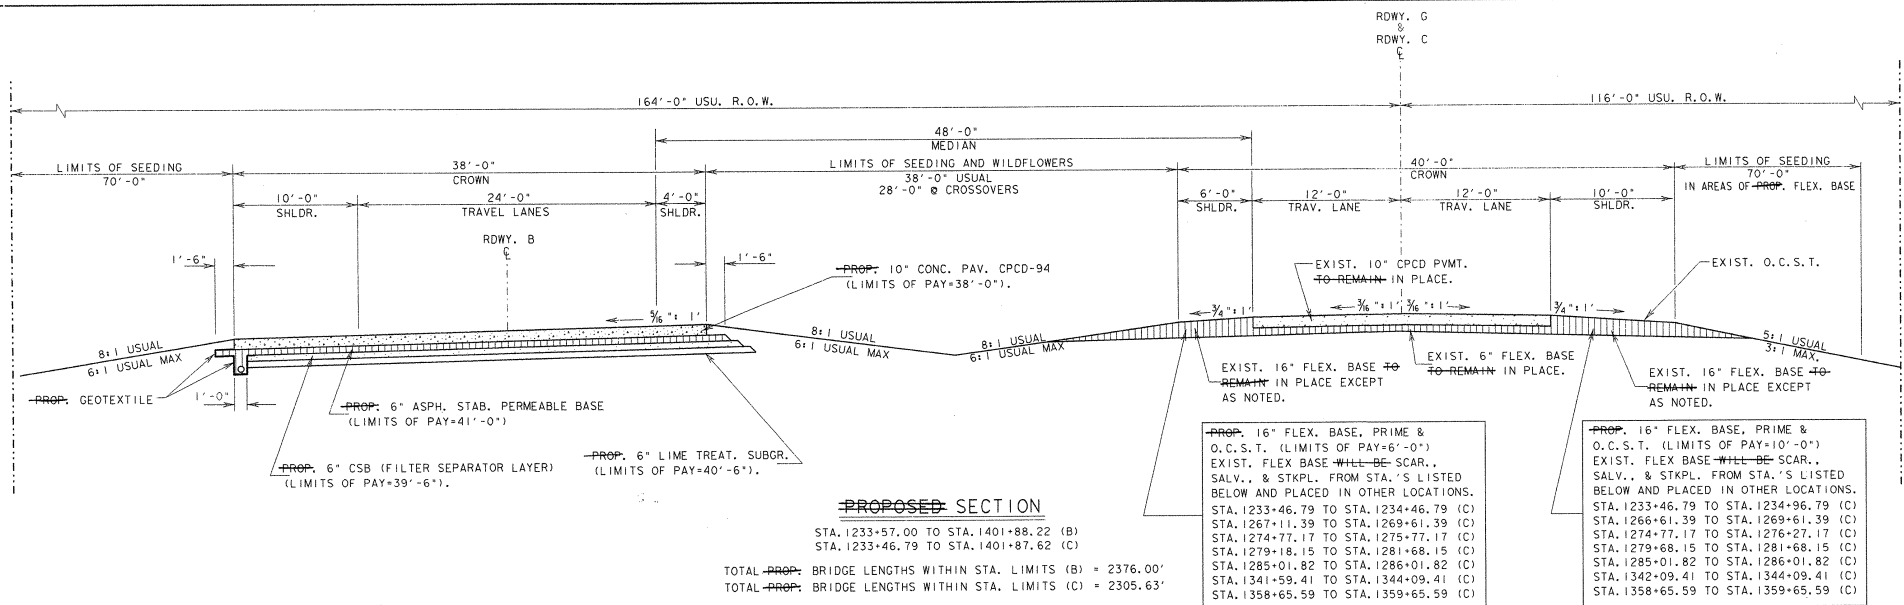

## TYPICAL CROSS SECTIONS



U.S. HWY. 90



The seal appearing on this document was authorized by Edward F. Seymour Jr., P.E. 25415, on 12/18/1945

*Edward F. Seymour Jr.*

SHEET NO.	STATE	FEDERAL AID PROJECT NO.	SHEET NO.
6	TEXAS	BR 95(161), etc.	7
DATE	COUNTY	NO.	NO.
12/18/45	LIBERTY	0028	03
			US 90

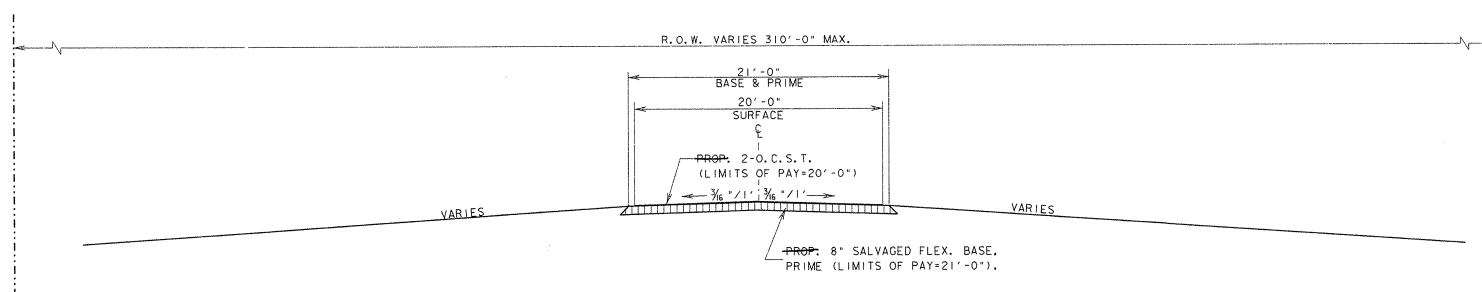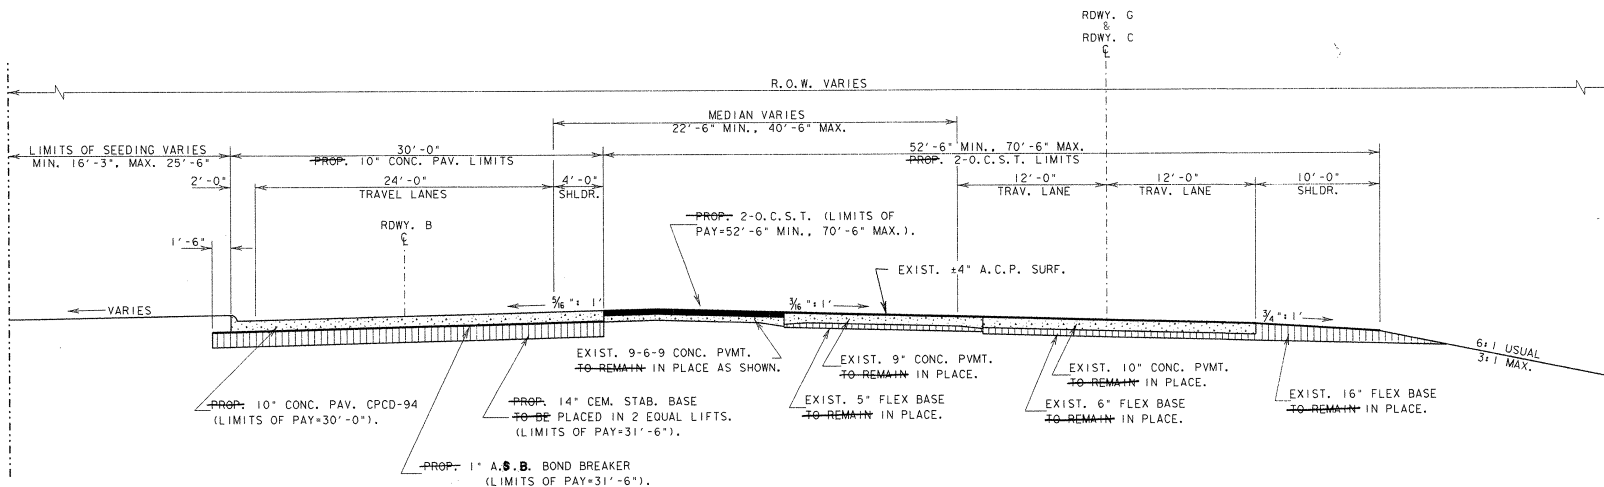

## TYPICAL CROSS SECTIONS

U.S. HWY. 90



The seal appearing on this document was authorized by Edward F. Seymour, Jr., P.E. 25415, on 12/15, 1995

*Edward F. Seymour, Jr.*

DIST. NO.	STATE	FEDERAL AID PROJECT NO.	SHEET NO.
20	TEXAS	BR 95(161), etc.	8
DIST. NO.	COUNTY	CONTRACT NO.	SECTION NO.
20	LIBERTY	0028	03
			US 90



CAST IN PLACE CONCRETE TRAFFIC BARRIER

#8 x 12" TIEBAR AT 4' C-C SPACING. ALL TIEBARS IN ANY CONTINUOUS PIECE OF CONCRETE TRAFFIC BARRIER SHALL BE ON THE SAME SIDE OF THE JOINT.

TWO LAYERS OF 30# ROOFING FELT WITH GRAPHITE LIGHTLY SPRINKLED BETWEEN LAYERS


CONCRETE PAVEMENT

8" MIN.

6" MIN.

FREE LONGITUDINAL JOINT WITH NO TIEBARS. LOCATION OF THE JOINT WILL BE AS DIRECTED BY THE ENGINEER FORMED WITH PREFORMED FIBER BOARD OR ASPHALT BOARD IN ACCORDANCE WITH ITEM "JOINT SEALANT AND FILLERS".

FREE LONGITUDINAL JOINT DETAIL

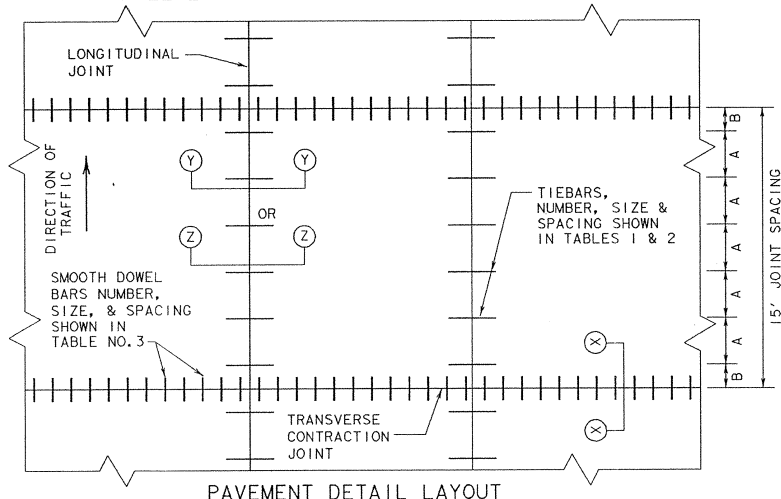


PAVEMENT DETAIL LAYOUT


TABLE NO. 1 TIEBARS REQUIRED FOR LONGITUDINAL JOINT JOINTS FOR EACH 15' SLAB						
ASTM A-616 OR A-615 (GRADE 60) STRAIGHT OR MULTIPLE PIECE REINFORCING TIEBARS		CONCRETE SLAB THICKNESS	DISTANCE FROM THE LONGITUDINAL JOINT TO THE NEAREST LONGITUDINAL FREE EDGE			
BAR LENGTH, "L" INCHES	BAR SIZE	*T* INCHES	< OR = 16'	< OR = 24'	< OR = 34'	< OR = 50'
42	#5 (3/16")	8	5	5	6	9
		9	5	5	7	10
		10	5	5	7	11
		11	5	6	8	12
		12	5	6	9	13
		13	5	7	9	13
		14	6	7	10	NA
		15	6	8	11	NA
50	#6 (3/8")	8	5	5	5	6
		9	5	5	5	7
		10	5	5	5	8
		11	5	5	6	8
		12	5	5	6	9
		13	5	5	7	10
		14	5	5	7	10
		15	5	6	8	11

THE DISTANCE TO THE FREE EDGE WILL BE DETERMINED BY THE ENGINEER AND THE DISTANCE WILL BE BASED ON THE NOMINAL WIDTHS OF THE LANES AND SHOULDERS PLUS ANY TIED RAMPS OR CONNECTING ROADWAYS.


TABLE NO. 2 TIEBAR SPACINGS		
SPACING REQUIREMENT FOR 15' SLAB FOR REQUIRED NUMBER OF BARS		
REQUIRED NO. OF BARS	REGULAR SPACING "A" INCHES	FIRST AT JOINT "B" INCHES
5	36	18
6	30	15
7	25	15
8	21	16.5
9	18	18
10	16	18
11	15	15
12	13	18.5
13	12	18

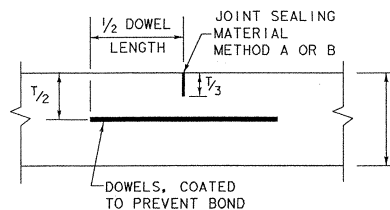

TRANSVERSE CONTRACTION JOINT SECTION X-X

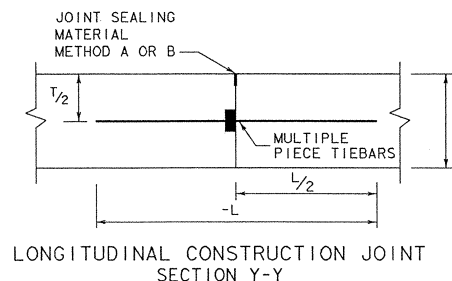

LONGITUDINAL CONSTRUCTION JOINT SECTION Y-Y

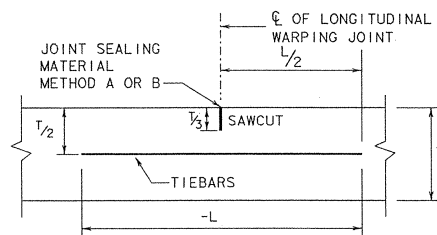

LONGITUDINAL WARPING JOINT SECTION Z-Z

TABLE NO. 3 DOWELS REQUIREMENTS		
T, IN.	DOWELS (SMOOTH BARS)	
	SIZE AND LENGTH	AVERAGE SPACING (INCHES)
8	1" x 18"	12
9	1 1/4" x 18"	12
10	1 1/4" x 18"	12
11	1 3/8" x 18"	12
12	1 1/2" x 18"	12
13	1 5/8" x 18"	12
14	1 3/4" x 18"	12
15	1 7/8" x 18"	12

## GENERAL NOTES

1. CONCRETE SLABS WIDER THAN 100' WITHOUT A FREE JOINT, ARE NOT COVERED BY THIS STANDARD.
2. FOR FURTHER INFORMATION REGARDING THE PLACEMENT OF CONCRETE AND LOAD TRANSFER DEVICES REFER TO THE GOVERNING SPECIFICATIONS FOR "CONCRETE PAVEMENT" AND "REINFORCING STEEL."
3. DETAILS FOR PAVEMENT WIDTH, PAVEMENT THICKNESS, AND CROWN CROSS SLOPE SHALL BE AS SHOWN ELSEWHERE IN THE PLANS.
4. THE DETAIL FOR THE JOINT SEALANT AND RESERVOIR WILL BE SHOWN IN CONCRETE PAVEMENT DETAIL, JOINT SEALANT STANDARD (JS-94).
5. PAVEMENT WIDTHS IN EXCESS OF 16' SHALL BE PROVIDED WITH A LONGITUDINAL JOINT (SECTION Z-Z OR Y-Y). THESE JOINTS SHALL BE LOCATED WITHIN 6" OF THE LANE LINES UNLESS SHOWN ELSEWHERE ON THE PLANS.
6. THE JOINT BETWEEN OUTSIDE LANE AND SHOULDER SHALL BE A LONGITUDINAL WARPING JOINT (SECTION Z-Z) UNLESS OTHERWISE SHOWN IN THE PLANS.
7. THE SPACING BETWEEN TRANSVERSE JOINTS SHALL BE 15 FEET UNLESS OTHERWISE SHOWN IN THE PLANS.
8. WHERE A MONOLITHIC CURB IS SPECIFIED, THE JOINT IN THE CURB SHALL COINCIDE WITH PAVEMENT JOINTS AND MAY BE FORMED BY ANY MEANS APPROVED BY THE ENGINEER.
9. TRANSVERSE CONSTRUCTION JOINTS MAY BE FORMED BY USE OF METAL OR WOOD FORMS EQUAL IN DEPTH TO THE NOMINAL DEPTH OF THE PAVEMENT, OR BY METHODS APPROVED BY THE ENGINEER.
10. THE ENGINEER WILL ADJUST THE REQUIRED NUMBER OF TIEBARS FOR SLABS SHORTER OR LONGER THAN 15'. SPACING "B" WILL BE ADJUSTED TO MAINTAIN A MINIMUM CLEARANCE OF 2" BETWEEN THE TIEBAR AND THE DOWEL BARS AT THE TRANSVERSE JOINT AND THE "A" SPACING WILL REMAIN AS REQUIRED FOR THE PAVEMENT SLAB WIDTH.
11. MULTIPLE PIECE TIEBARS SHALL BE USED AT LONGITUDINAL CONSTRUCTION JOINTS UNLESS OTHERWISE SPECIFIED IN THE PLANS.
12. THE SAW CUT FOR LONGITUDINAL WARPING AND THE TRANSVERSE CONSTRUCTION JOINTS MAY BE ONE FOURTH THE SLAB THICKNESS WHEN CRUSHED LIMESTONE IS USED AS THE COARSE AGGREGATE.

ACC. / JUC/0481303  
FILE: CPCD94.DGN

Texas Department of Transportation  
Design Division (Pavement)

## CONCRETE PAVEMENT DETAILS CONTRACTION DESIGN T-8 THROUGH 15 INCHES CPCD-94

DATE DRAWN: SEPT. 1994	DESIGNER: LJB	CHECKER: BGD	DATE: 08-1994	PROJECT: BR 95(61) ETC.	195
MODIFICATIONS:	DATE: 20	BY: 6	REASON: BR 95(61) ETC.	195	
	COUNTY: LIBERTY	SECTION: 0028	DATE: 03	BY: 061	US 90