
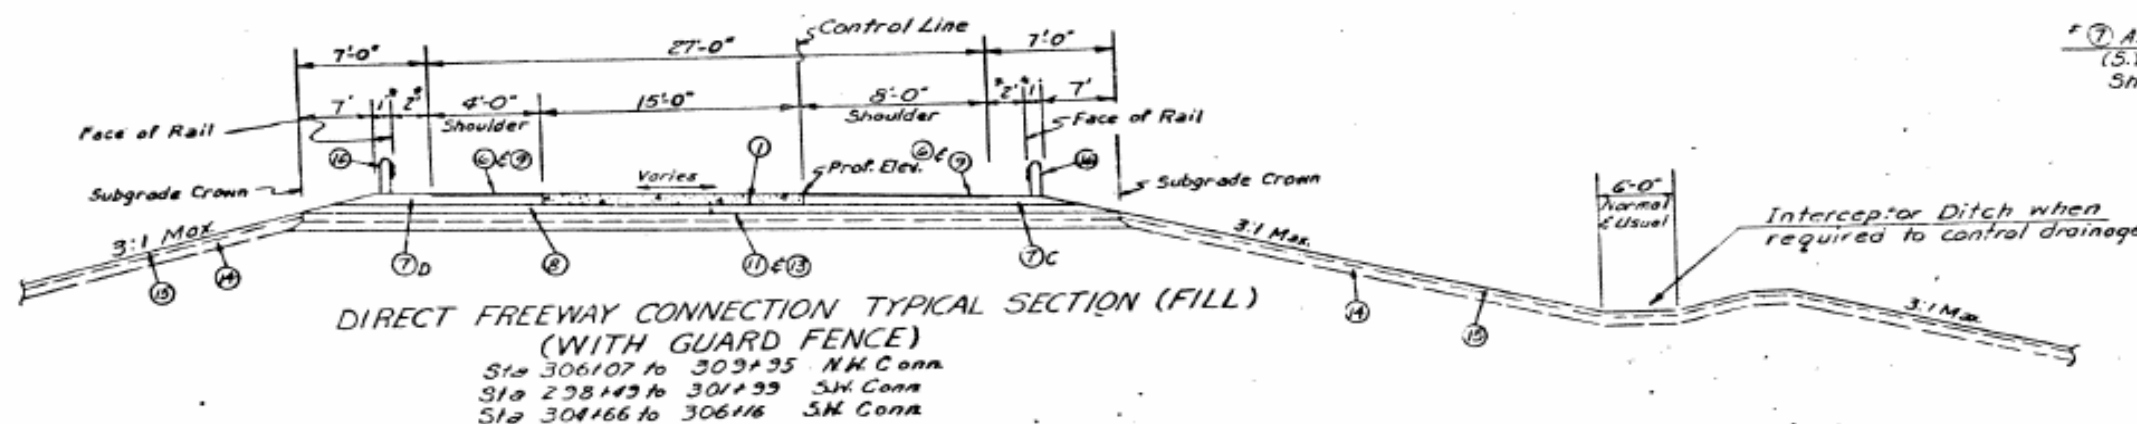
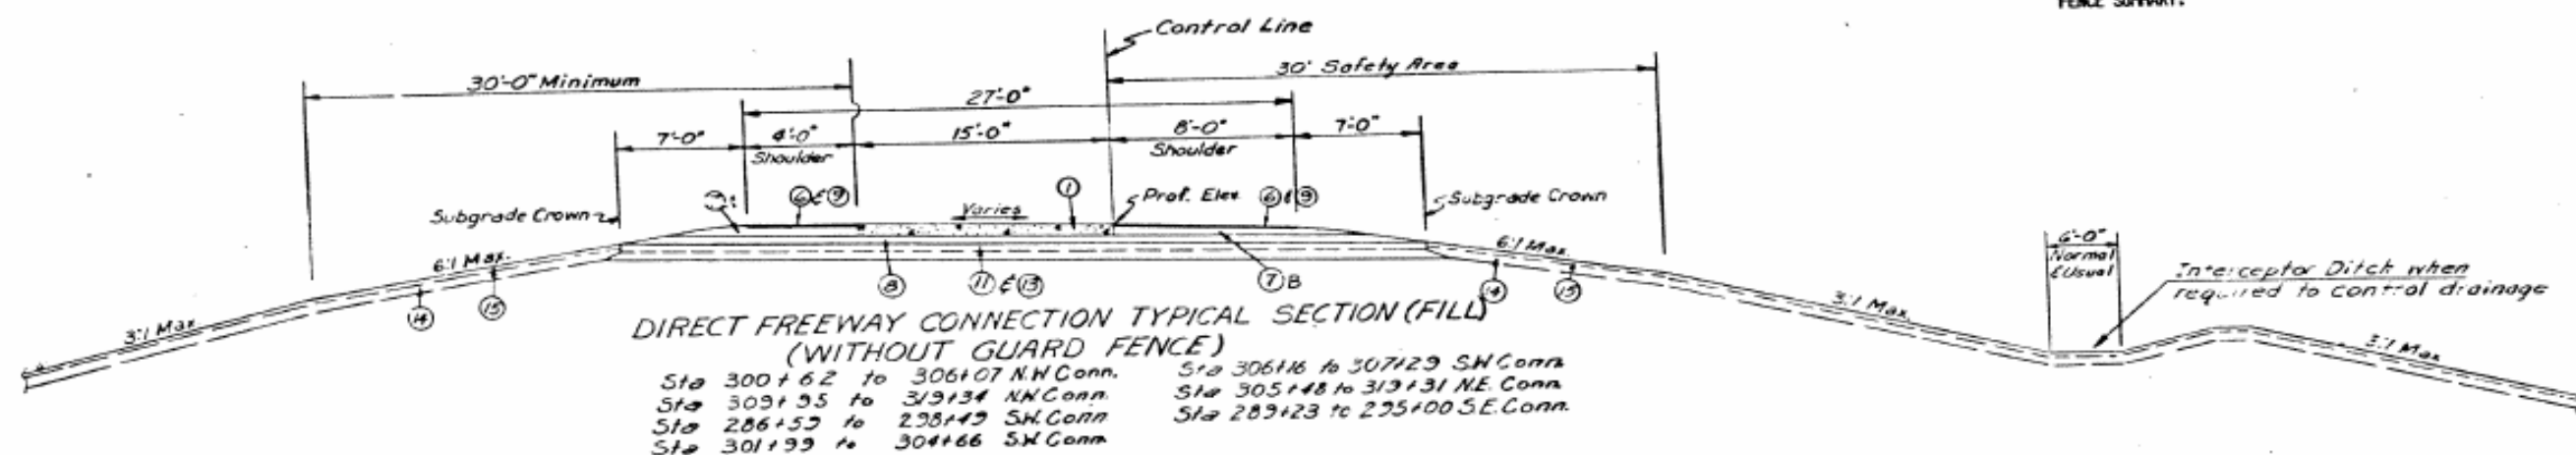


LEGEND

1. 8" CONTINUOUS REINFORCED CONCRETE PAVEMENT (CRCP)
 2. 8" CONCRETE PAVEMENT CONTRACTION DESIGN (CPCD)
 3. 10" UNIFORM CONCRETE PAVEMENT (CPCD)
 4. 125#/S.Y. ASPHALTIC CONCRETE PAVEMENT
 5. ASPHALT STABILIZED BASE
 6. APPROX. 6" SOIL CEMENT BASE (PLANT MIX)
 7. TACK COAT
 8. APPROX. 6" SUBGRADE STABILIZED WITH 4% LIME
 9. APPROX. 6" UNDERCUT IN ROCK CUTS BACKFILLED WITH SELECT MATERIAL
 10. APPROX. 12" SELECT MATERIAL
 11. APPROX. 6" TOPSOIL
 12. APPROX. 3" (COMPACTED) MULCH SOD, BRODST. SEEDING AND FERTILIZER
 13. GALVANIZED STEEL BEAM 60. FENCE (CL. B) WHERE REQUIRED*
 14. 3/4" EXPANSION JOINT MATERIAL
 15. EXISTING CONCRETE PAVEMENT
 16. JIGGLE BARS
 17. BRIDGE COLUMN
 18. RIPRAP
 19. TRAFFIC BUTTON
 20. TYPE I CURB (5")
 21. TYPE III CURB (3")
 22. 6" PIPE UNDERDRAIN
 23. 5" DOWELLED CONCRETE MEDIAN (CL. B CONC.)
 24. TYPE II CURB (4")
- *REQUIRED WHERE SLOPE OF EMBANKMENT IS GREATER THAN 6:1 WITHIN THIRTY FEET OF THE OUTSIDE FREEWAY LANE LINE AND AS SHOWN ON GALVANIZED STEEL BEAM GUARD FENCE SUMMARY.

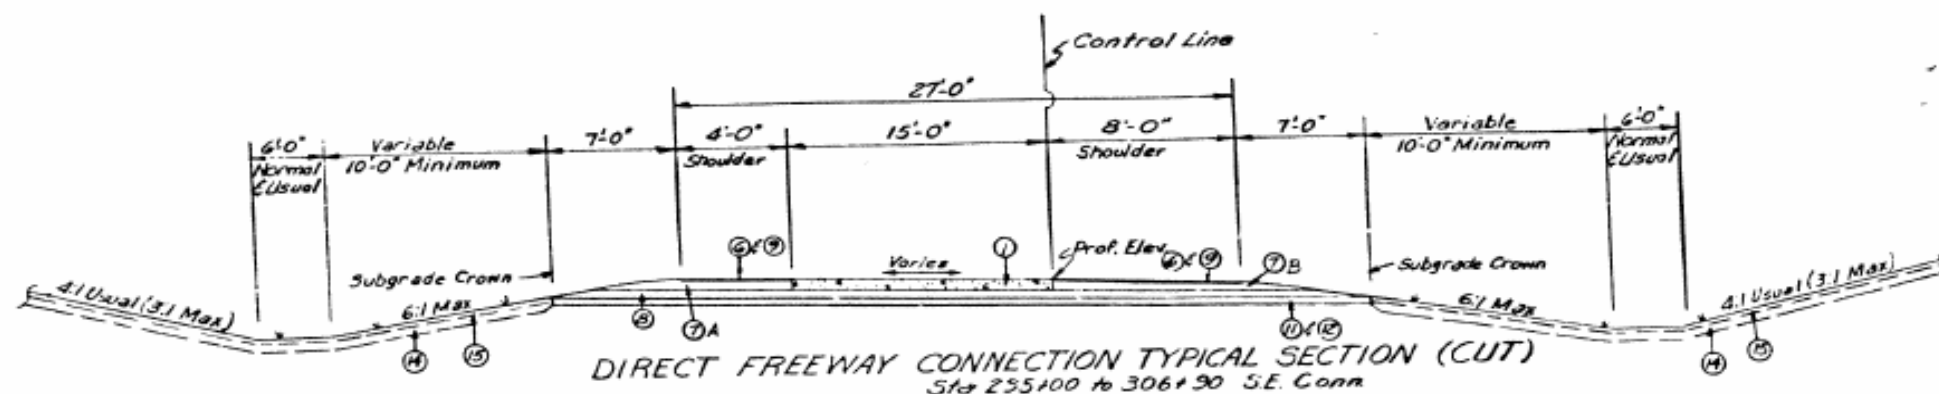


* ① Asphalt Stabilized Base Shoulders (S.Y.'s for Av. Note are based on Shoulder widths indicated below.)

7A	1133' / S.Y. @ 4'
7B	951' / S.Y. @ 8'
7C	922' / S.Y. @ 11'
7D	1012' / S.Y. @ 6'
7E	844' / S.Y. @ 8'
7F	971' / S.Y. @ 4'
7G	856' / S.Y. @ 6'
7H	735' / S.Y. @ 9'
7I	633' / S.Y. @ 13'
7J	1097' / S.Y. @ 10'
7K	990' / S.Y. @ 8'
7L	1220' / S.Y. @ 6'

TYPICAL SECTIONS
SHEET 1 OF 5 SHEETS

REV.	DATE	BY	CHKD.	PROJECT NO.
1	10-2-71	145-3		

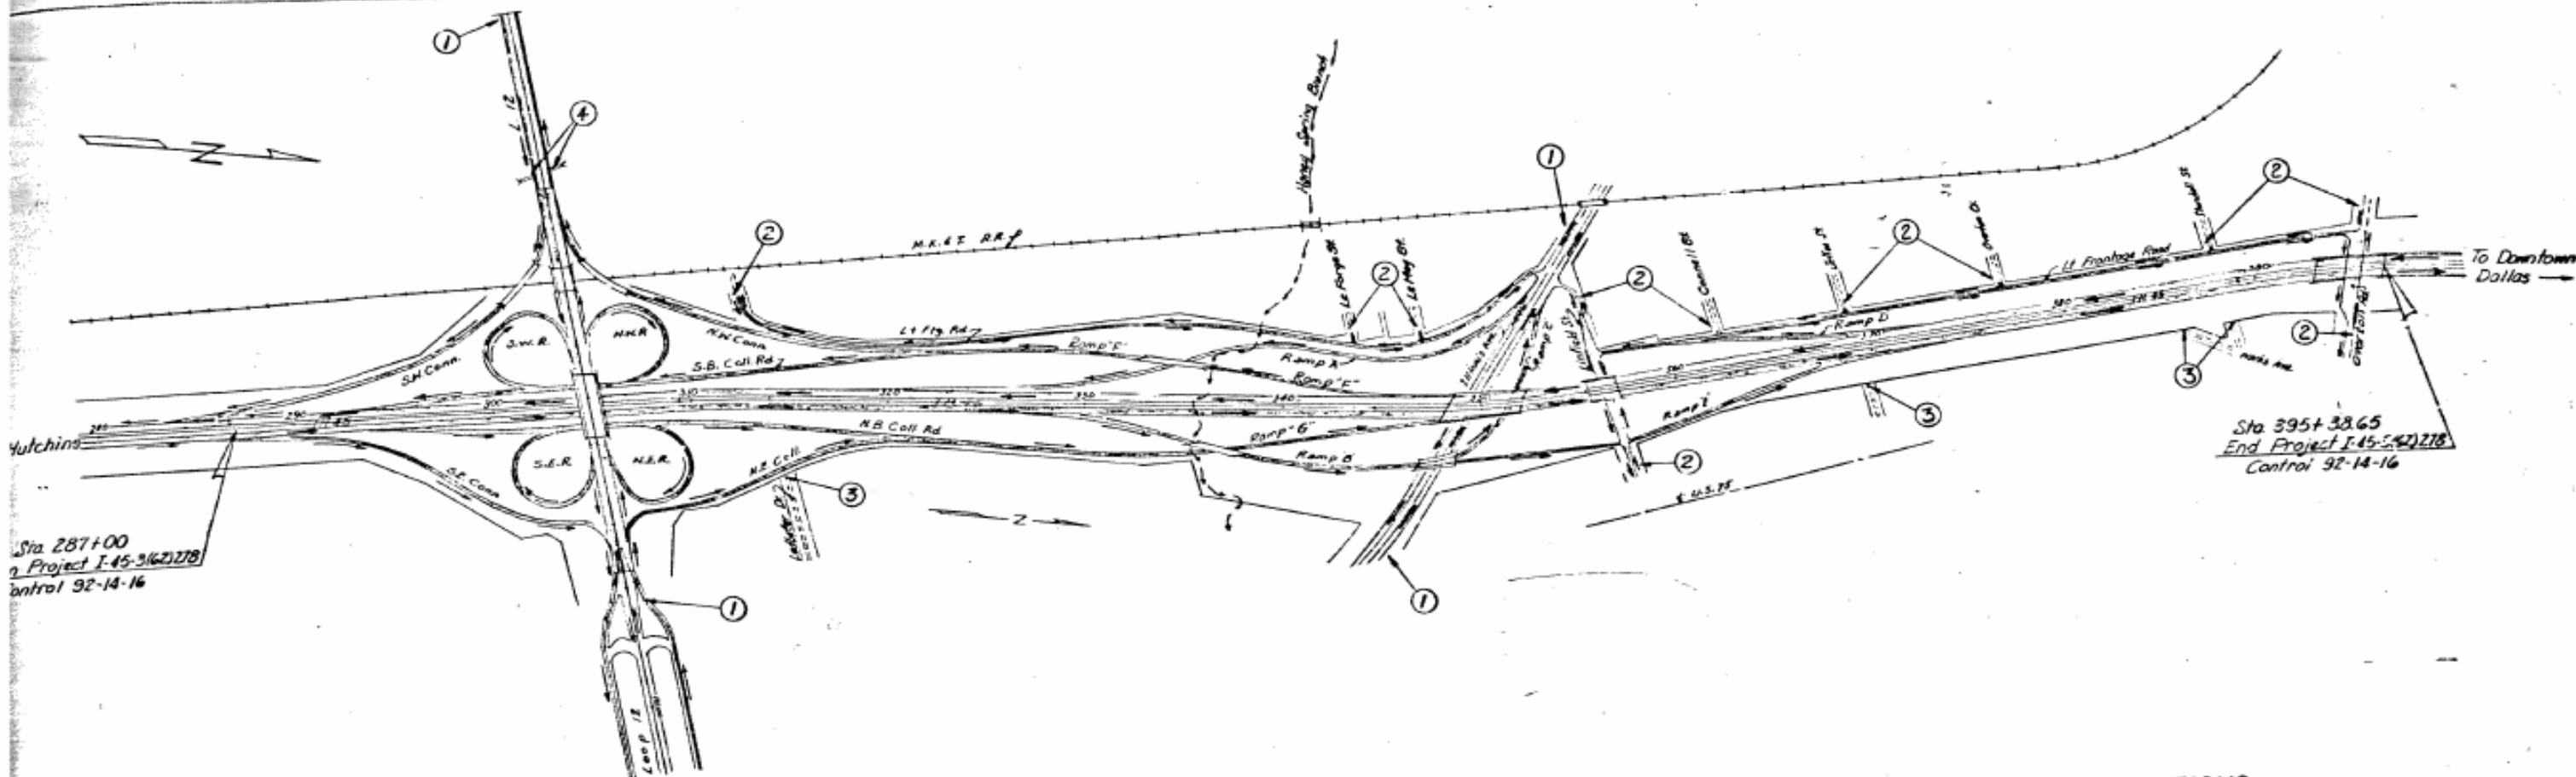

Sta 287+00
Project I-45-3(62)278
Control 92-14-16

Sta 395+38.65
End Project I-45-3(62)278
Control 92-14-16

BARRICADE LOCATIONS

The Contractor shall provide and erect barricades and warning signs in accordance with BC(1)-70, BC(2)-70, BC(3)-70, BC(4)-70, BC(5)-70 and BC(6)-70 Standards at points indicated and at other points as directed by the Engineer.
Construction identification signs for Federal Aid Projects shall be erected in accordance with CIS-71 Standard.

③ CLASS II BARRICADE with Signs R10-Z


④ CLASS I (D) BARRICADE To Be Erected At Each Culvert Widening.

① CLASS I (C) BARRICADES with Signs W20-1C, W20-1B, W20-1A, R10-8, G20-2, G20-6 AND C-1.

To Be Placed At Each End Of Construction On Loop 12 And At IH-45 Avenue.

② CLASS I (C) BARRICADE with Signs W13-4, W21-4A AND G20-2.

To Be Placed At Street Intersections As Directed By The Engineer.



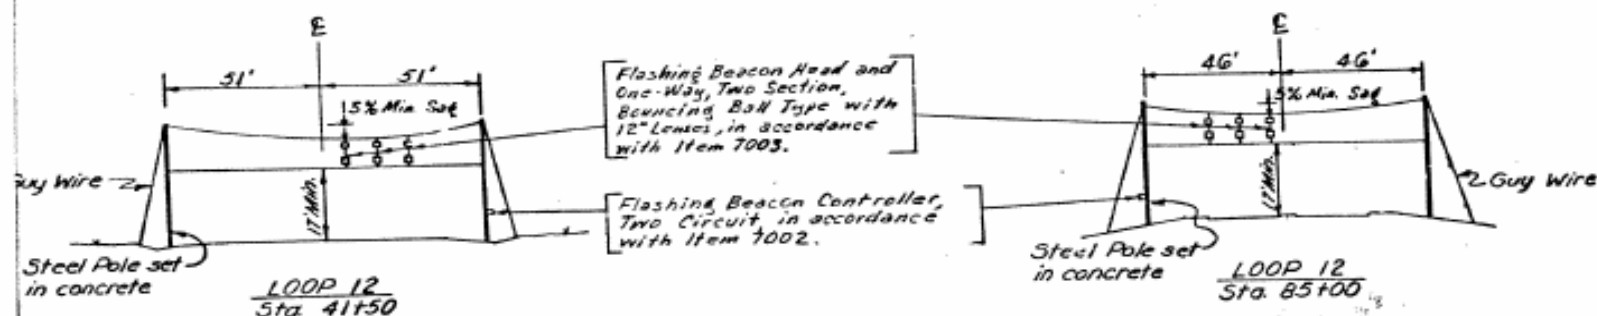


PROPOSED BEACONS ON LOOP 12 @ IH-45

NOTE: At Each Truck Crossing or Road Machinery Crossing, Place Signs W13-4, W21-8, W21-3 AND W11-1 As Directed By The Engineer.

PROJECT LAYOUT

NO. 10	STAGE	PROJECT NO. 1000	2
NO. 11	STAGE	PROJECT NO. 1000	2
NO. 12	STAGE	PROJECT NO. 1000	2
NO. 13	STAGE	PROJECT NO. 1000	2
NO. 14	STAGE	PROJECT NO. 1000	2
NO. 15	STAGE	PROJECT NO. 1000	2
NO. 16	STAGE	PROJECT NO. 1000	2
NO. 17	STAGE	PROJECT NO. 1000	2
NO. 18	STAGE	PROJECT NO. 1000	2
NO. 19	STAGE	PROJECT NO. 1000	2
NO. 20	STAGE	PROJECT NO. 1000	2

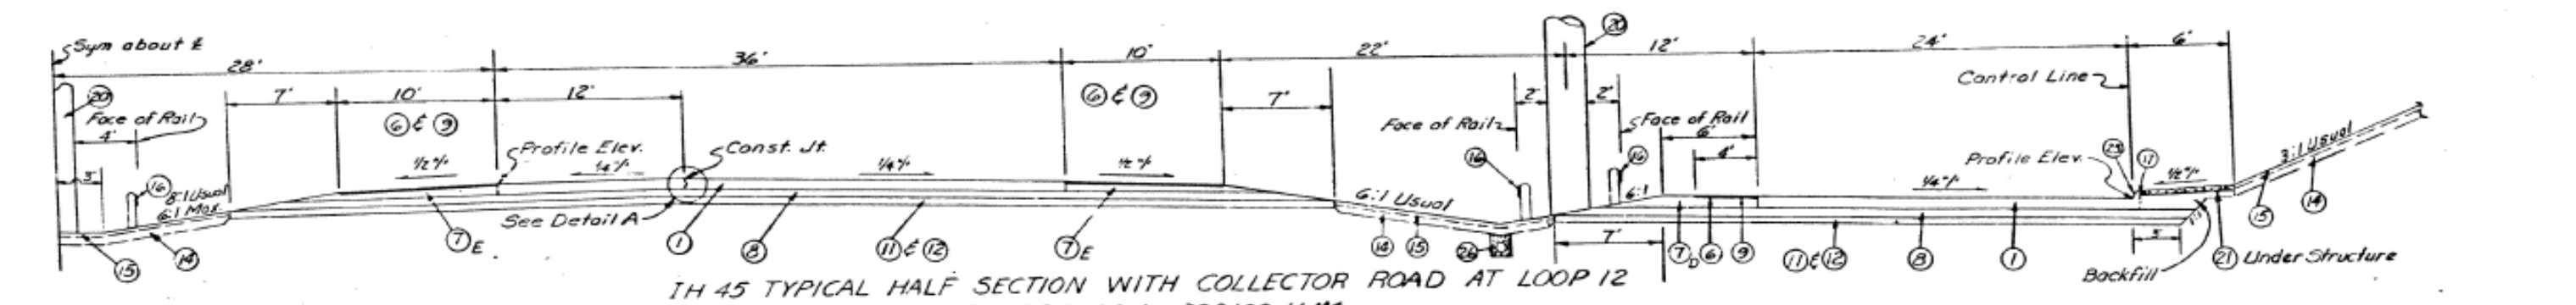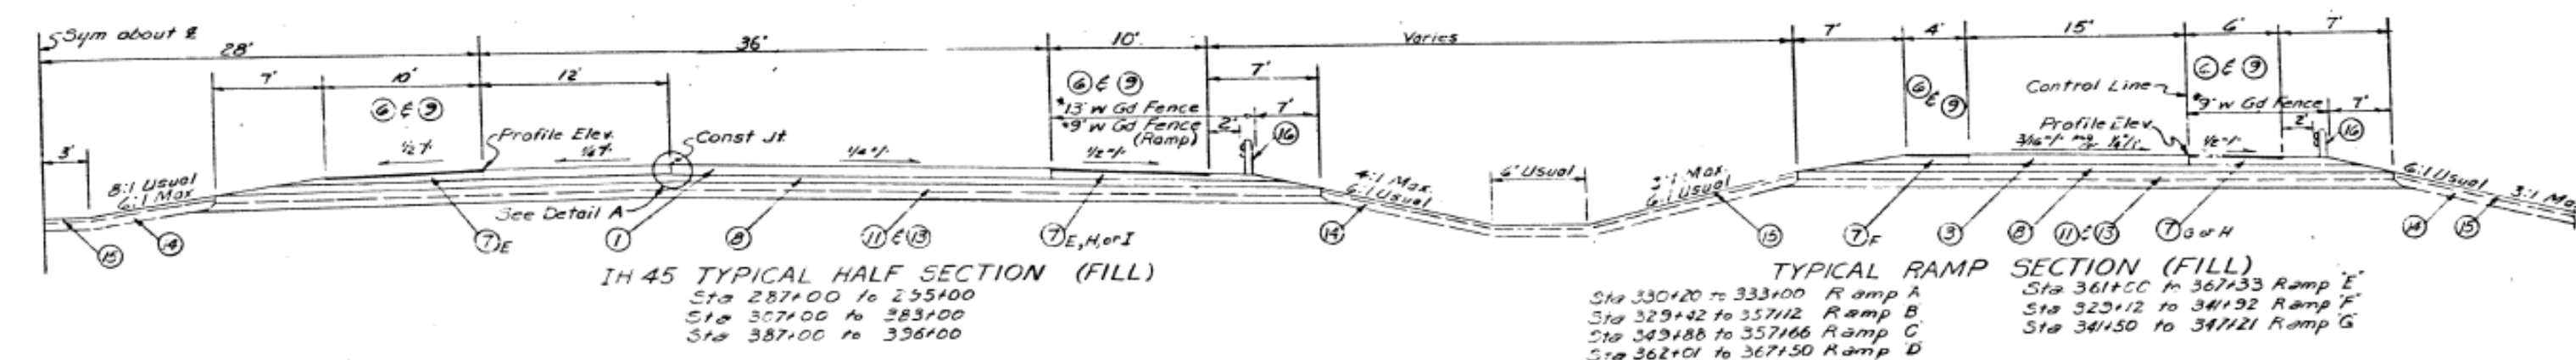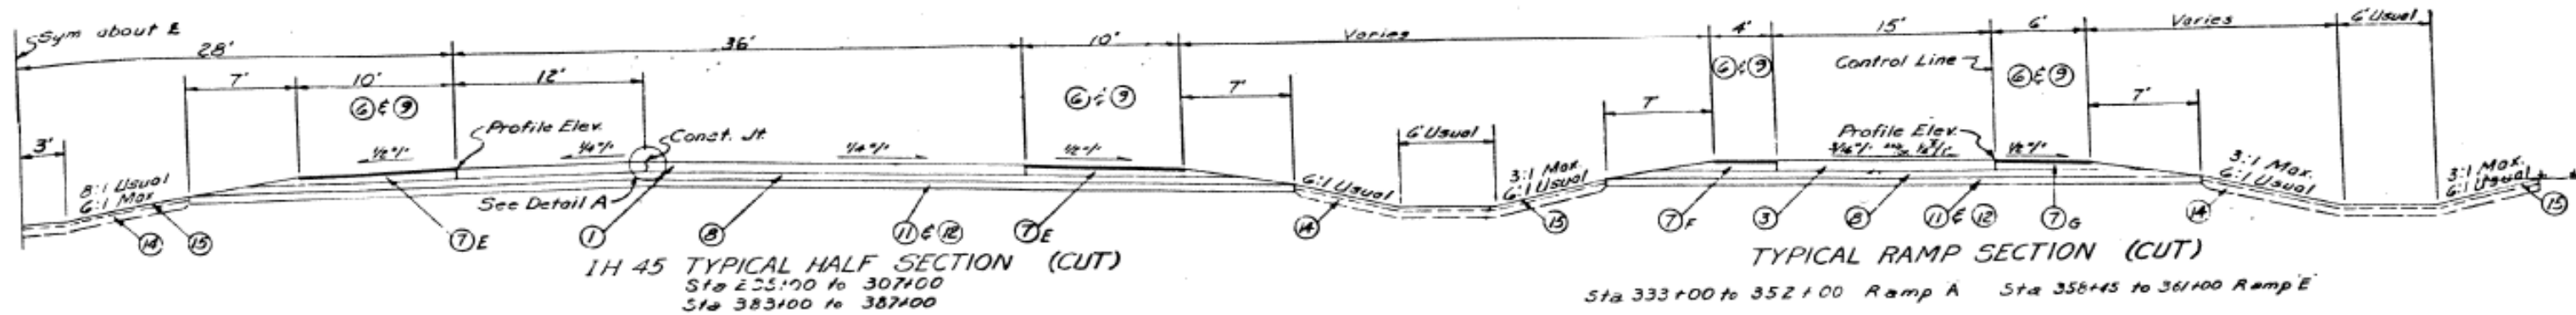


Asphalt Stabilized Base Shoulders
(S.Y.s for A.R. Rate are based on
Shoulder widths indicated below)

7A	1133'SY @ 6'
7B	951'SY @ 8'
7C	902'SY @ 11'
7D	1012'SY @ 6'
7E	844'SY @ 8'
7F	971'SY @ 4'
7G	856'SY @ 6'
7H	755'SY @ 9'
7I	633'SY @ 13'
7J	1097'SY @ 10'
7K	990'SY @ 8'
7L	1220'SY @ 5'

- LEGEND**
- 8" CONTINUOUS REINFORCED CONCRETE PAVEMENT (CRCP)
 - 8" CONCRETE PAVEMENT CONTRACTION DESIGN (CPCD)
 - 10" UNIFORM CONCRETE PAVEMENT (CPCD)
 - 125#/S.Y. ASPHALTIC CONCRETE PAVEMENT
 - ASPHALT STABILIZED BASE
 - APPROX. 6" SOIL CEMENT BASE (PLANT MIX)
 - TACK COAT
 - APPROX. 6" SUBGRADE STABILIZED WITH 4% LIME
 - APPROX. 6" UNDERCUT IN ROCK CUTS BACKFILLED WITH SELECT MATERIAL
 - APPROX. 12" SELECT MATERIAL
 - APPROX. 6" TOPSOIL
 - APPROX. 3" (COMPACTED) MULCH SOD, BRDCST. SEEDING AND FERTILIZER
 - GALVANIZED STEEL BEAM G.D. FENCE (CL. B) WHERE REQUIRED*
 - 3/4" EXPANSION JOINT MATERIAL


- EXISTING CONCRETE PAVEMENT
- JIGGLE BARS
- BRIDGE COLUMN
- RIPRAP
- TRAFFIC BUTTON
- TYPE I CURB (5")
- TYPE III CURB (3")
- 6" PIPE UNDERDRAIN

27. 5" DOWELLED CONCRETE MEDIAN (CL. B CONC.)
28. TYPE II CURB (4")
*REQUIRED WHERE SLOPE OF EMBANKMENT IS GREATER THAN 6:1 WITHIN THIRTY FEET OF THE OUTSIDE FREEWAY LANE LINE AND AS SHOWN ON GALVANIZED STEEL BEAM GUARD FENCE SUMMARY.

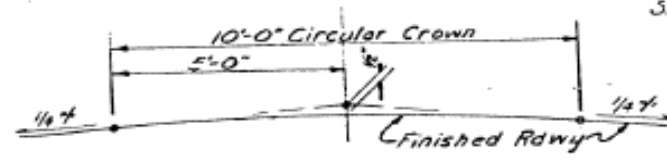


4
TYPICAL SECTIONS
SHEET 2 OF 5 SHEETS

FILE NO.	STATE	FEDERAL PROJECT NO.
145-3(62)278	TEXAS	
COUNTY	CORR.	SHEET
DALLAS		32

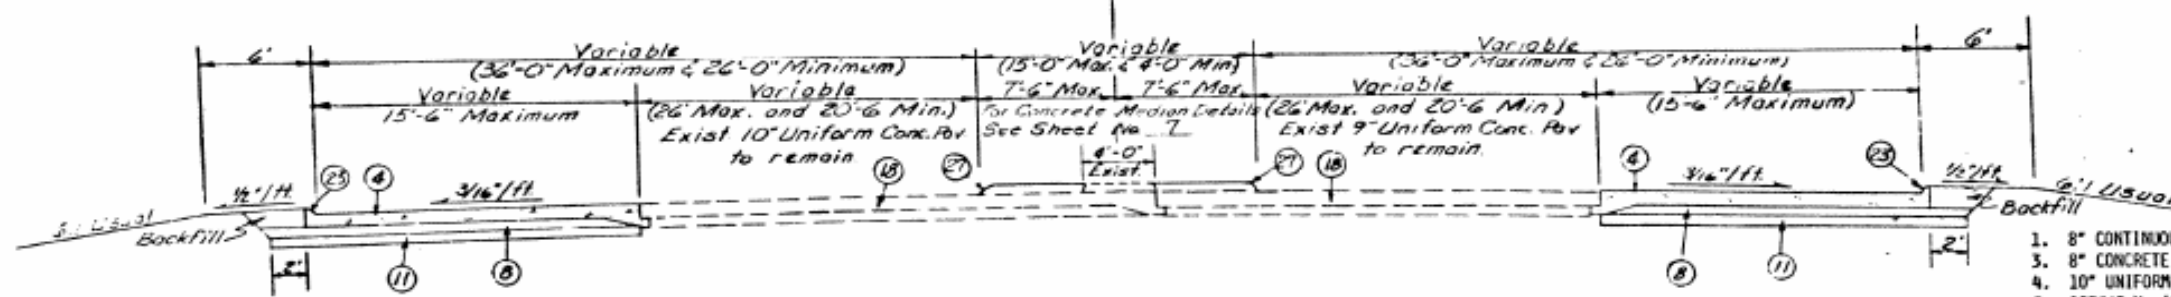

LOOP 12 TYPICAL SECTION
Sta 73+50 to 76+30

- LEGEND
1. 8" CONTINUOUS REINFORCED CONCRETE PAVEMENT (CRCP)
 2. 8" CONCRETE PAVEMENT CONTRACTION DESIGN (CPCD)
 3. 10" UNIFORM CONCRETE PAVEMENT (CPCD)
 4. 125#/S.Y. ASPHALTIC CONCRETE PAVEMENT
 5. ASPHALT STABILIZED BASE
 6. APPROX. 6" SOIL CEMENT BASE (PLANT MIX)
 7. TACK COAT
 8. APPROX. 6" SUBGRADE STABILIZED WITH 4% LIME
 9. APPROX. 6" UNDERCUT IN ROCK CUTS BACKFILLED WITH SELECT MATERIAL
 10. APPROX. 12" SELECT MATERIAL
 11. APPROX. 6" TOPSOIL
 12. APPROX. 3" (COMPACTED) MULCH SOD, BRODST. SEEDING AND FERTILIZER
 13. GALVANIZED STEEL BEAM G.D. FENCE (CL. B) WHERE REQUIRED*
 14. 3/4" EXPANSION JOINT MATERIAL
 15. EXISTING CONCRETE PAVEMENT
 16. JIGGLE BARS
 17. BRIDGE COLUMN
 18. RIPRAP
 19. TRAFFIC BUTTON
 20. TYPE I CURB (5")
 21. TYPE II CURB (3")
 22. 6" PIPE UNDERDRAIN
 23. 5" DOWELLED CONCRETE MEDIAN (CL. B CONC.)
 24. TYPE II CURB (4")

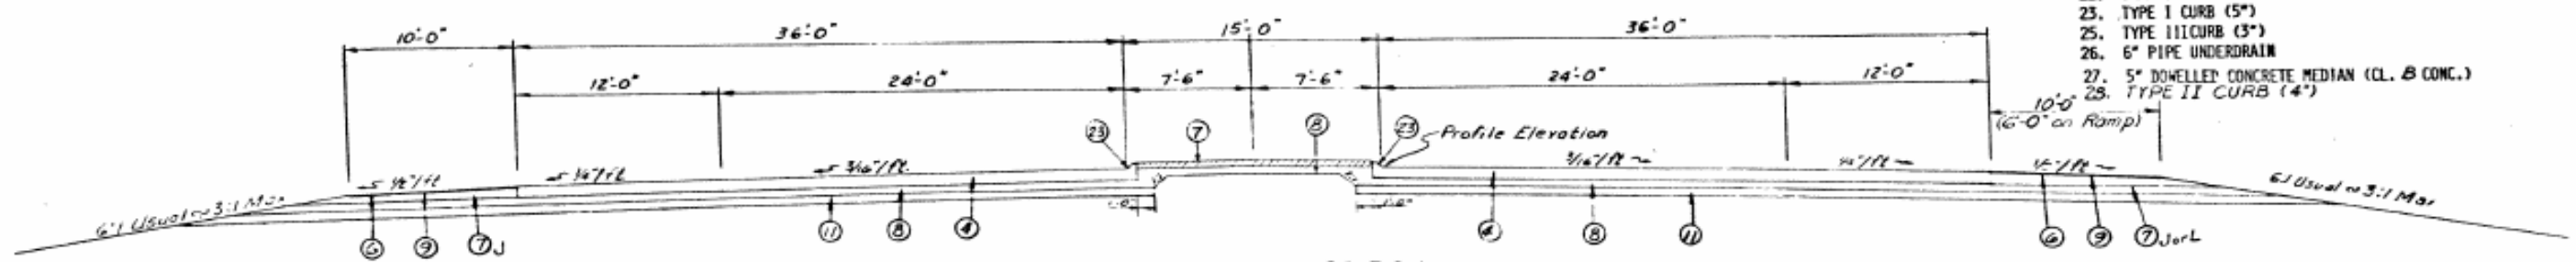

LOOP 12 TYPICAL SECTION
Sta 57+41 to 64+00
Sta 65+39 to 72+50
Sta 53+00 to 57+74


*REQUIRED WHERE SLOPE OF EMBANKMENT IS GREATER THAN 6:1 WITHIN THIRTY FEET OF THE OUTSIDE FREEWAY LANE LINE AND AS SHOWN ON GALVANIZED STEEL BEAM GUARD FENCE SUMMARY.

⑦ Asphalt Stabilized Base Shoulders

(S.Y.'s for Av. Rate are based on
Shoulder widths indicated below)

7A	1133'SY	@ 8'
7B	551'SY	@ 8'
7C	902'SY	@ 11'
7D	1042'SY	@ 6'
7E	844'SY	@ 8'
7F	971'SY	@ 6'
7G	856'SY	@ 6'
7H	735'SY	@ 9'
7I	633'SY	@ 13'
7J	1097'SY	@ 10'
7K	990'SY	@ 8'
7L	1220'SY	@ 6'

6.7 Units

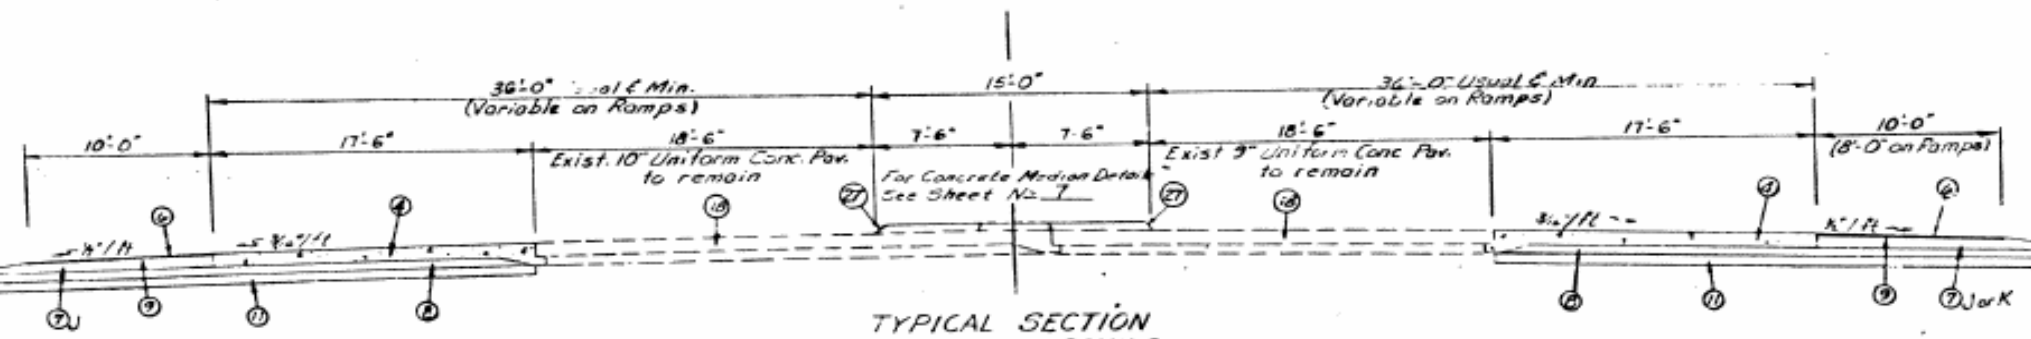


TYPICAL SECTION
LOOP 12 WIDENING
Sta 42+34 to 53+00
Sta 72+50 to 73+50


TYPICAL SECTIONS
SHEET 3 OF 5 SHEETS

REV. 10-6-71


FILE NO.	STATE	GENERAL PROJECT NO.	SHEET
18	TEXAS	145-3(62)278	3
DATE	COUNTY	CONTRACT NO.	
1971	DALLAS	32	

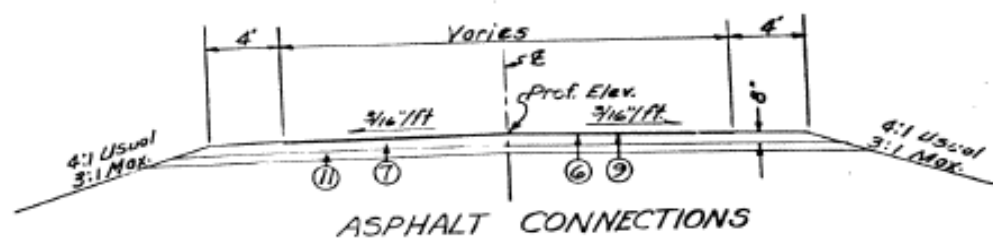


Sta. 0+00 to Sta. 1+00 & Sta. 6+51 to Sta. 8+45 LINFIELD STREET
Sta. 6+95 to Sta. 7+46 & Sta. 12+00 to Sta. 12+55 OVERTON ROAD

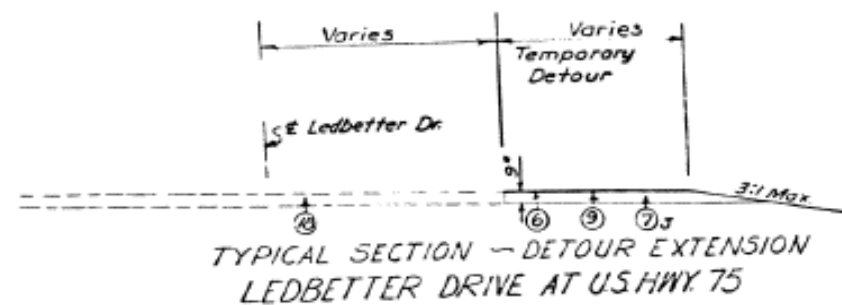

- LEGEND
- 8" CONTINUOUS REINFORCED CONCRETE PAVEMENT (CRCP)
 - 8" CONCRETE PAVEMENT CONTRACTION DESIGN (CPCD)
 - 10" UNIFORM CONCRETE PAVEMENT (CPCD)
 - 125#/S.Y. ASPHALTIC CONCRETE PAVEMENT
 - ASPHALT STABILIZED BASE
 - APPROX. 6" SOIL CEMENT BASE (PLANT MIX)
 - TACK COAT
 - APPROX. 6" SUBGRADE STABILIZED WITH 4% LIME
 - APPROX. 6" UNDERCUT IN ROCK CUTS BACKFILLED WITH SELECT MATERIAL
 - APPROX. 12" SELECT MATERIAL
 - APPROX. 6" TOPSOIL
 - APPROX. 3" (COMPACTED) MULCH SOD, BRODST. SEEDING AND FERTILIZER
 - GALVANIZED STEEL BEAM G.D. FENCE (CL. B) WHERE REQUIRED*
 - 3/4" EXPANSION JOINT MATERIAL
 - EXISTING CONCRETE PAVEMENT
 - JIGGLE BARS
 - BRIDGE COLUMN
 - RIPRAP
 - TRAFFIC BUTTON
 - TYPE I CURB (5")
 - TYPE III CURB (3")
 - 6" PIPE UNDERDRAIN
 - 5" DOWELLED CONCRETE MEDIAN (CL. B CONC.)
 - TYPE II CURB (4")
- *REQUIRED WHERE SLOPE OF EMBANKMENT IS GREATER THAN 6:1 WITHIN THIRTY FEET OF THE OUTSIDE FREEWAY LANE LINE AND AS SHOWN ON GALVANIZED STEEL BEAM GUARD FENCE SUMMARY.

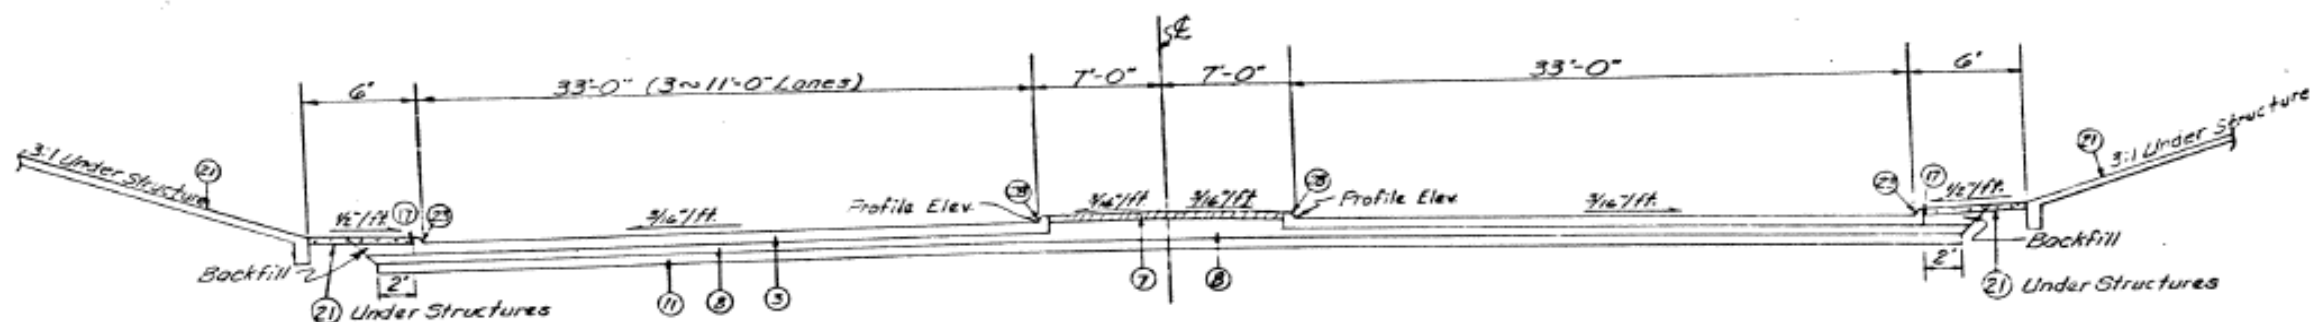

TYPICAL SECTION LINFIELD STREET
Sta. 3+20 to Sta. 6+51

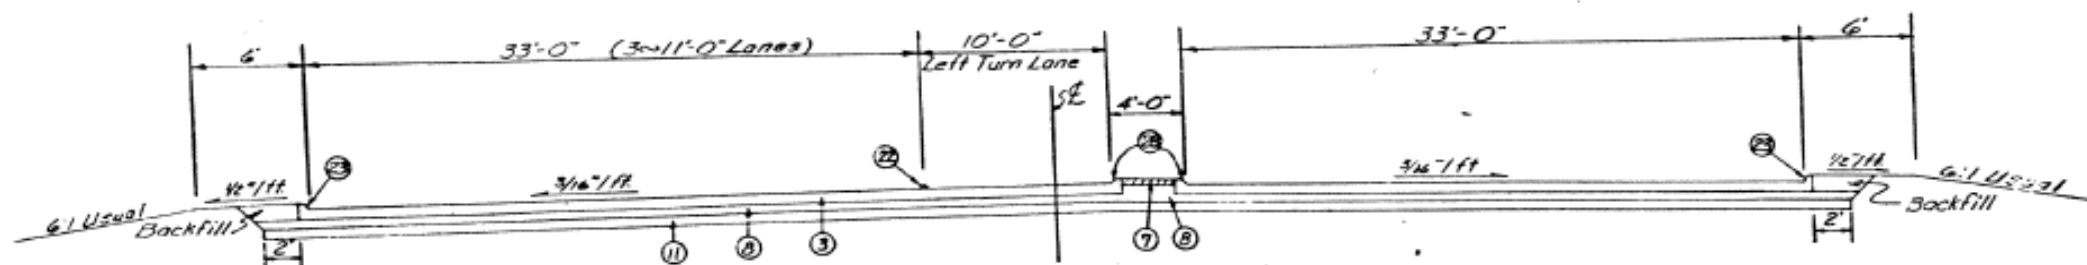

TYPICAL SECTION LINFIELD STREET
AND OVERTON ROAD
Sta. 1+00 to Sta. 3+20 LINFIELD STREET
Sta. 7+46 to Sta. 12+00 OVERTON ROAD


*⑦ Asphalt Stabilized Base Shoulders
(5.1's for Av. Rate are based on
Shoulder widths indicated below)

7A	1133' SY @ 4'
7B	951' SY @ 8'
7C	902' SY @ 11'
7D	1012' SY @ 6'
7E	844' SY @ 8'
7F	971' SY @ 4'
7G	856' SY @ 6'
7H	735' SY @ 9'
7I	633' SY @ 13'
7J	1097' SY @ 10'
7K	990' SY @ 8'
7L	1220' SY @ 6'


TYPICAL SECTIONS
SHEET 4 OF 5 SHEETS

REV. 10-2-71


DATE	STATE	FEDERAL PROJECT NO.	SHEET
10-2-71	TEXAS	145-3(62)278	6
BY	COUNTY	CHRG. AGENT	DATE
W. J. DALLAS			10-2-71

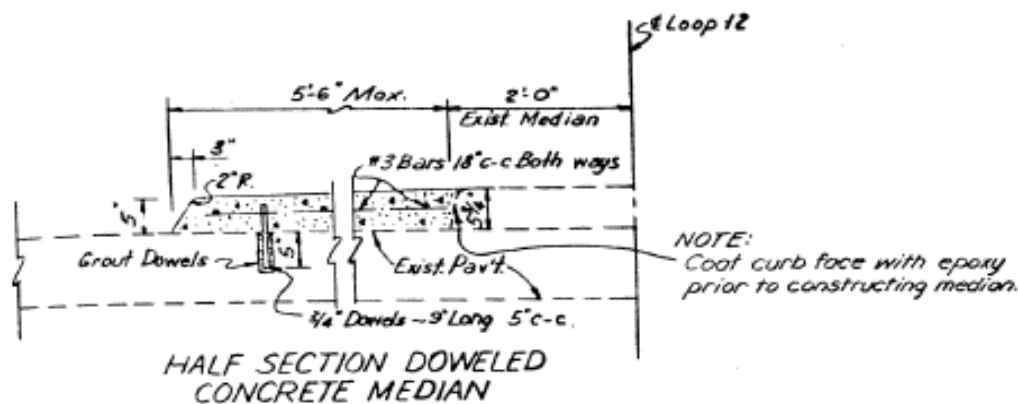


NOTE: Use dowels only on sections four feet or less.

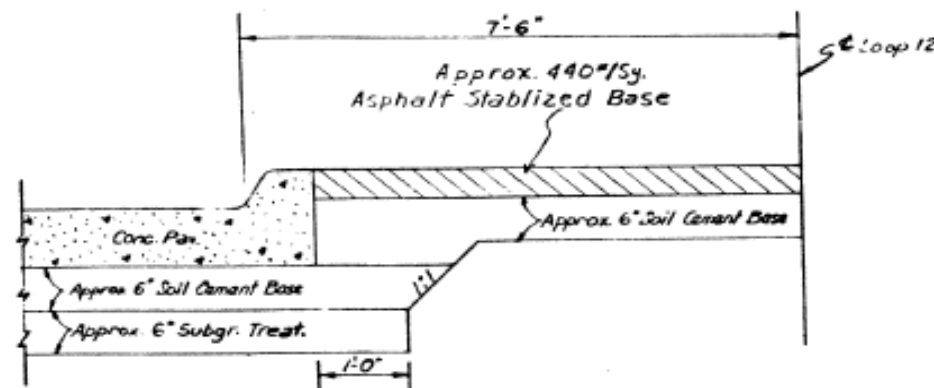


HALF SECTION A.S.B. MEDIAN

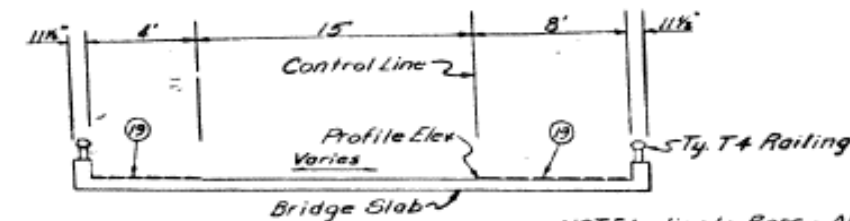

TYPICAL SECTION CONNECTION BRIDGE

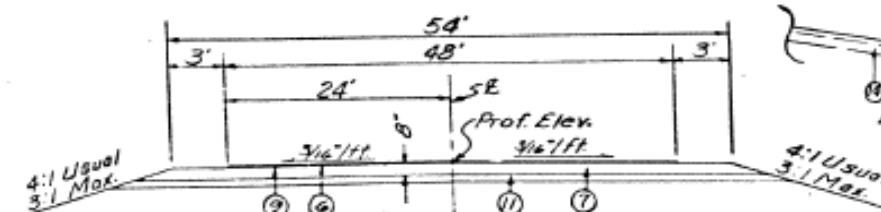


DETOUR TYPICAL SECTION TWO WAY TRAFFIC AT LOOP 12

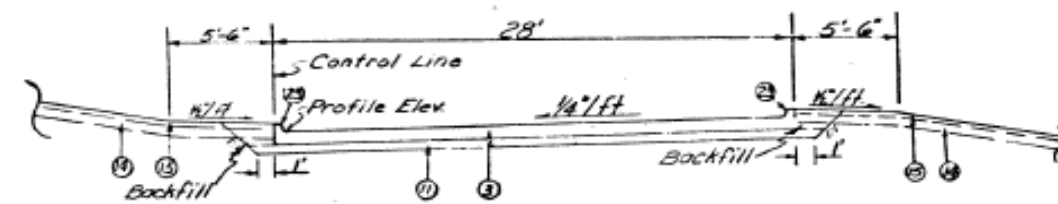


CURBED FRONTAGE ROAD TYPICAL SECTION

Sta 31121 to 354+52
Sta 354+00 to 394+63

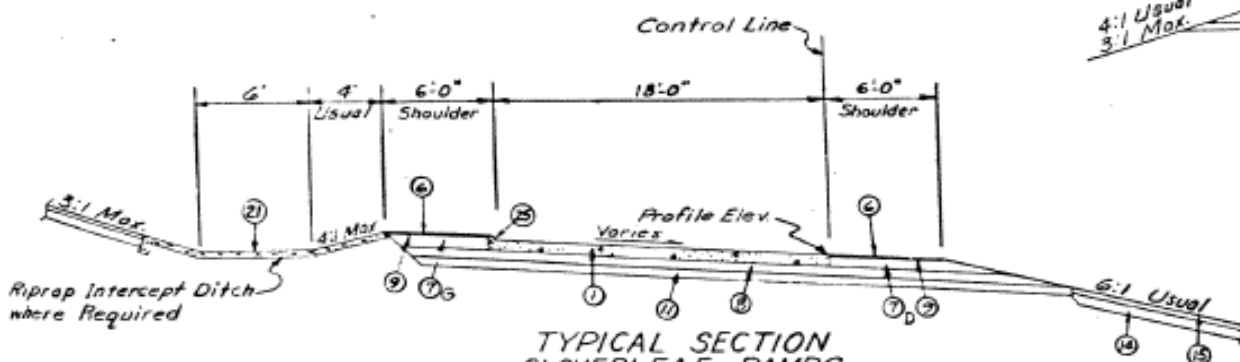

TYPICAL SECTION CLOVERLEAF RAMPS AT LOOP 12

2138 to 3141 NE Ramp Sta 3100 to 10145 SW Ramp
1163 to 3161 SE Ramp Sta 1121 to 3100 NW Ramp

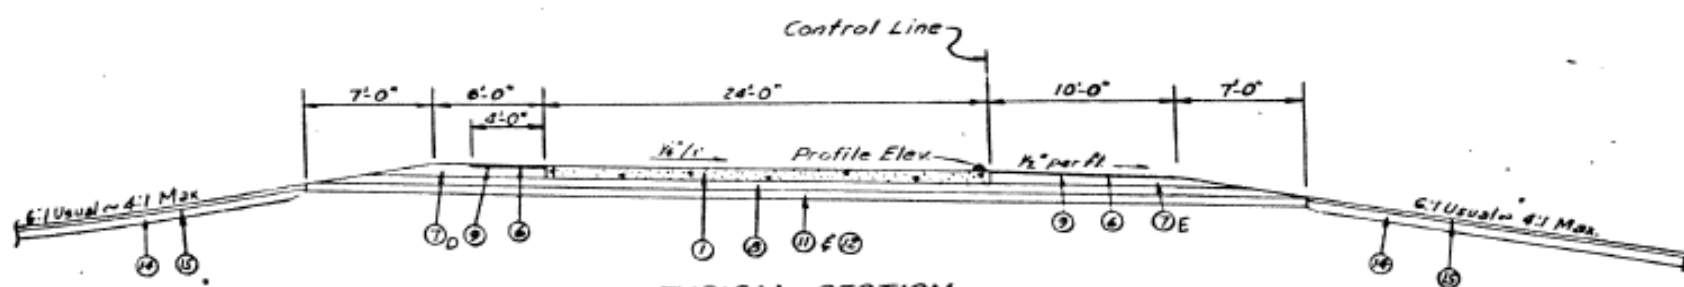

TYPICAL SECTION COLLECTOR ROADS

Sta 309+00 to 329+12 LM
Sta 309+00 to 341+50 RM

LEGEND

- 8" CONTINUOUS REINFORCED CONCRETE PAVEMENT (CRCP)
- 8" CONCRETE PAVEMENT CONTRACTION DESIGN (CPCD)
- 10" UNIFORM CONCRETE PAVEMENT (CPCD)
- 125#/S.Y. ASPHALTIC CONCRETE PAVEMENT
- ASPHALT STABILIZED BASE
- APPROX. 6" SOIL CEMENT BASE (PLANT MIX)
- TACK COAT
- APPROX. 6" SUBGRADE STABILIZED WITH 4% LIME
- APPROX. 6" UNDERCUT IN ROCK CUTS BACKFILLED WITH SELECT MATERIAL
- APPROX. 12" SELECT MATERIAL
- APPROX. 6" TOPSOIL
- APPROX. 3" (COMPACTED) MULCH SPD, BRODST. SEEDING AND FERTILIZER
- GALVANIZED STEEL BEAM G.D. FENCE (CL. B) WHERE REQUIRED*
- 3/4" EXPANSION JOINT MATERIAL
- EXISTING CONCRETE PAVEMENT
- JIGGLE BARS
- BRIDGE COLUMN
- RIPRAP
- TRAFFIC BUTTON
- TYPE I CURB (5")
- TYPE III CURB (3")
- 6" PIPE UNDERDRAIN
- 5" DOWELED CONCRETE MEDIAN (CL. A CONC.)
- TYPE II CURB (4")

*REQUIRED WHERE SLOPE OF EMBANKMENT IS GREATER THAN 6:1 WITHIN THIRTY FEET OF THE OUTSIDE FREEWAY LANE LINE AND AS SHOWN ON GALVANIZED STEEL BEAM GUARD FENCE SUMMARY.


⑦ Asphalt Stabilized Base Shoulders
(S.Y.'s for Av. Rate are based on Shoulder widths indicated below.)

7A	1133'/S.Y. @ 4'
7B	951'/S.Y. @ 8'
7C	902'/S.Y. @ 11'
7D	1012'/S.Y. @ 6'
7E	844'/S.Y. @ 8'
7F	971'/S.Y. @ 4'
7G	856'/S.Y. @ 6'
7H	735'/S.Y. @ 9'
7I	633'/S.Y. @ 13'
7J	1097'/S.Y. @ 10'
7K	990'/S.Y. @ 8'
7L	1220'/S.Y. @ 6'

TYPICAL SECTIONS
SHEET 5 OF 5 SHEETS


REV. 10. 3- 91	SHEET 5 OF 5
FILE NO. 145-3(62)278	7
DATE 10/1/91	10/1/91
BY DALLAS	10/1/91

7

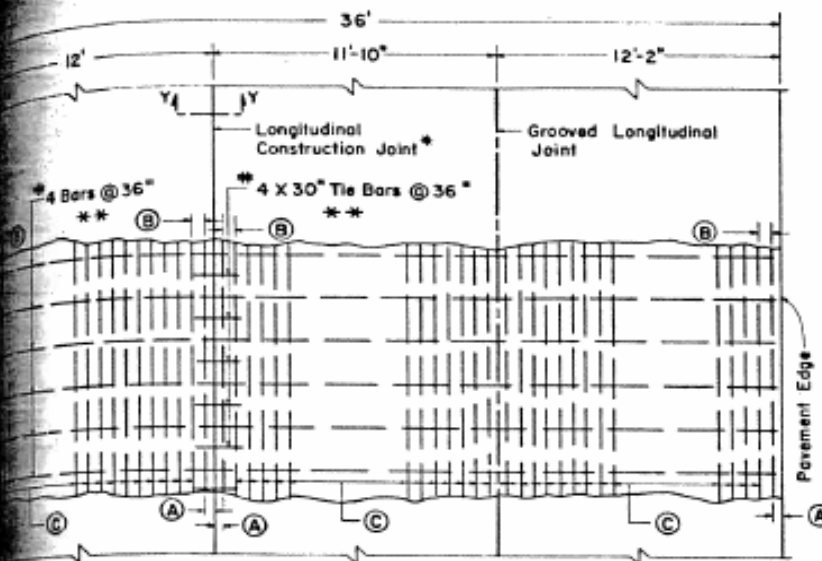


THREE LANE PAVEMENT PLAN
(12 ft. and 24 ft. Placement)

WITH THE APPROVAL OF THE ENGINEER, THE CONTRACTOR MAY PLACE THE PAVEMENT THE FULL ROADWAY WIDTH AS ONE PLACEMENT. IF SO PLACED, THE LONGITUDINAL CONSTRUCTION JOINT SHOWN SHALL BE REPLACED BY THE GROOVED LONGITUDINAL JOINT.

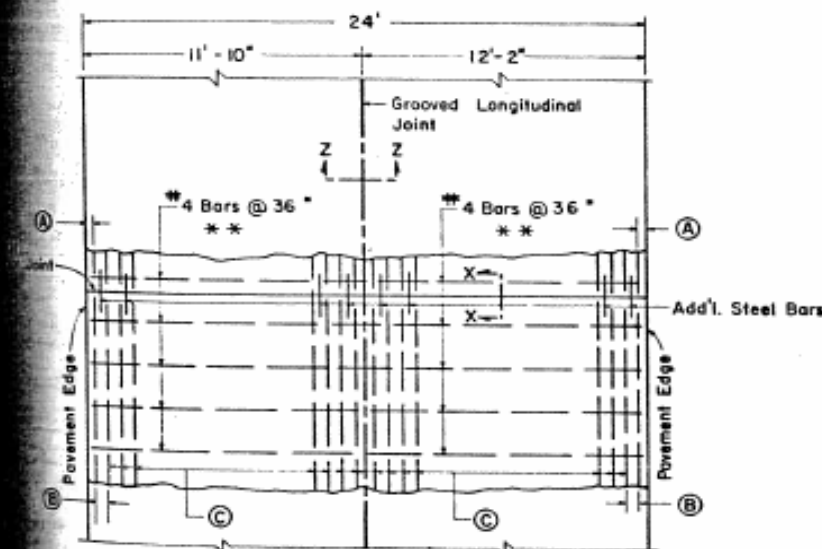


TWO LANE PAVEMENT PLAN
(24 ft. Placement)

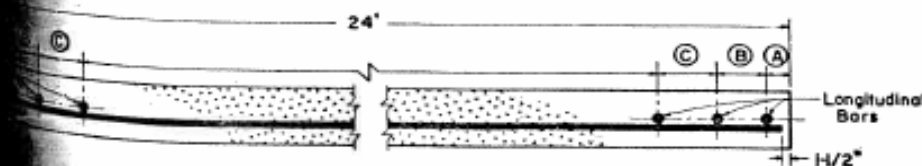


TYPICAL SECTION
(24 ft. Placement)

*LANE WIDTHS ARE FOR ILLUSTRATIVE PURPOSES ONLY AND SHOULD NOT BE USED IF IN CONFLICT WITH TYPICAL CROSS SECTIONS SHOWN ELSEWHERE IN THE PLANS.


Per Cent Long Steel	Pavement Thickness *7" in.	Bar Size	24 ft. Placement Width					12 ft. Placement Width					Add'l Steel @ Trans. Const. J.				
			Spacing c-c			No. of Bars	Steel #/ly ①	Spacing c-c			No. of Bars	Steel #/ly ①	Size	2/No. per 24' place. width	2/No. per 12' place. width	Weight #/ft. based on 12' placement	
			A In	B In	C In			A In	B In	C In							
0.5	10	No. 6	3	5	8.5	35	21.72	3	5.25	8.5	18	22.28	3/4"x36"	18	9	3.38	
	9	No. 5	3	4.5	6.5	45	19.60	3	4	6.5	23	20.00	5/8"x36"	22	11	2.87	
	8	No. 5	3	6	7.5	39	17.26	3	5.25	7.5	20	17.65	5/8"x36"	20	10	2.61	
	7	No. 5	3	5	8.5	35	15.69	4	8.5	8.5	17	15.30	5/8"x36"	18	9	2.35	
	6	No. 4	3	4.5	7	42	12.53	3	6	7	21	12.55	1/2"x36"	20	11	1.84	
0.6	10	No. 6	3	7	7.25	40	24.50	3	7.25	7.25	20	24.50	3/4"x36"	20	10	3.76	
	9	No. 6	3	5	8	52	22.04	3	5	8	19	22.41	3/4"x36"	19	10	3.76	
	8	No. 5	3	6.25	6.25	40	20.00	3	6.25	6.25	24	20.76	5/8"x36"	23	11	2.61	
	7	No. 5	3	7	7.25	40	17.65	3	7.25	7.25	20	17.65	5/8"x36"	20	10	2.61	
	6	No. 5	3	6	8.5	35	15.69	3	5.25	8.5	18	16.06	5/8"x36"	18	9	2.35	

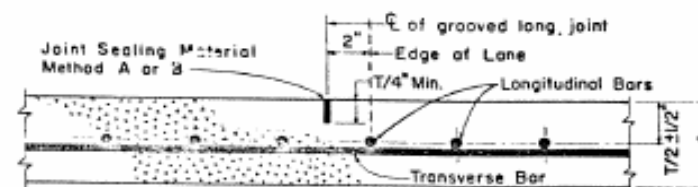

GROOVED LONGITUDINAL JOINT
Section Z-Z

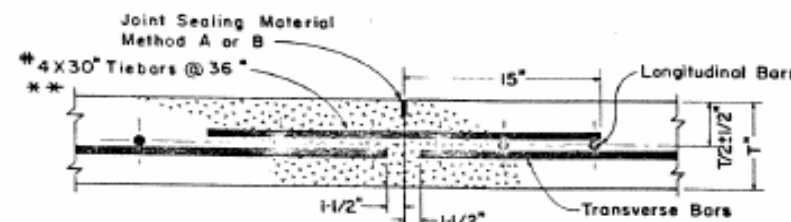

LONGITUDINAL CONSTRUCTION JOINT
Section Y-Y

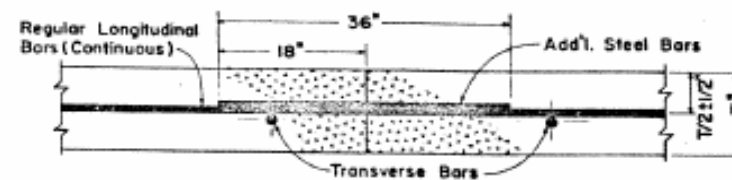

TRANSVERSE CONSTRUCTION JOINT
Section X-X

(REV)
** SEE DESIGN DETAIL REC(POR)-71A FOR STEEL REQUIREMENTS FOR RAMP CONNECTIONS.

GENERAL NOTES

- NO EXPANSION JOINTS WILL BE USED EXCEPT AT STRUCTURE ENDS OR FIXED OBJECTS AS SHOWN ELSEWHERE IN THE PLANS.
- FOR FURTHER INFORMATION REGARDING THE PLACEMENT OF CONCRETE AND REINFORCEMENT REFER TO THE GOVERNING SPECIFICATIONS FOR "CONCRETE PAVEMENT".
- DETAILS AS TO PAVEMENT WIDTH, PAVEMENT THICKNESS AND THE CROWN CROSS-SLOPE SHALL BE AS SHOWN ELSEWHERE IN THE PLANS.
- WITHIN ANY AREA BOUNDED BY TWO FEET OF PAVEMENT LENGTH MEASURED PARALLEL TO THE CENTERLINE AND TWELVE FEET OF PAVEMENT WIDTH MEASURED PERPENDICULAR TO THE PAVEMENT CENTERLINE, NOT OVER 33% OF THE REGULAR LONGITUDINAL STEEL SHALL BE SPLICED.
- LONGITUDINAL AND TRANSVERSE BARS SHALL BE STEEL CONFORMING TO ASTM A-615 OR ASTM A-616 (GRADE 60) AS NOTED IN THE SPECIFICATIONS.
- SPLICES SHALL BE A MINIMUM OF 24 TIMES THE NOMINAL DIAMETER OF THE BAR.
- BARS OF ASTM DESIGNATIONS: A-615 OR A-616, GRADE 60 STEEL SHALL NOT BE BENT. IF THE CONTRACTOR ELECTS TO BEND THE TIEBARS, THEY SHALL BE STEEL CONFORMING TO ASTM DESIGNATION: A-615, GRADE 60, AND SPACED AT 24" C-C.
- AT TRANSVERSE CONSTRUCTION JOINTS THE REGULAR LONGITUDINAL BARS SHALL EXTEND BEYOND THE JOINT SO THAT THE BAR SPLICES FOR THE REGULAR LONGITUDINAL BARS SHALL BE A MINIMUM OF FOUR FEET FROM THE CONSTRUCTION JOINT. AT LONGITUDINAL CONSTRUCTION JOINTS IF THE CONTRACTOR ELECTS TO CONTINUE THE REGULAR TRANSVERSE STEEL THROUGH THE JOINT, THE 84 (TIEBARS SHOWN HEREON MAY BE DELETED. VIBRATION WITH HAND MANIPULATED MECHANICAL VIBRATORS WILL BE REQUIRED ADJACENT TO ALL TRANSVERSE CONSTRUCTION JOINTS.
- WITH THE APPROVAL OF THE ENGINEER, MULTIPLE PIECE TIEBARS (THREADED COUPLING OR OTHER ADEQUATE DEVICE) MAY BE USED TO FACILITATE CONSTRUCTION PROVIDED THE SYSTEM DEVELOPS A FORCE EQUAL TO 1 1/2 TIMES THE MINIMUM YIELD FORCE OF THE TIEBAR SHOWN. THE SPACINGS FOR THE SYSTEM SHALL BE LESS THAN OR EQUAL TO THE SPACING ALLOWED FOR BARS OF SIMILAR YIELD STRENGTH.
- THE CHAIRS USED TO SUPPORT THE BAR MAT SHALL BE OF SUFFICIENT STRUCTURAL QUALITY AND NUMBER TO HOLD THE MAT WITHIN THE PLACEMENT HEIGHT TOLERANCES, AND SHALL BE OF A TYPE APPROVED BY THE ENGINEER.
- IN THE NORMAL 36" PLACEMENT FOR THE TRANSVERSE BARS, CHAIRS SHALL BE PLACED UNDER EVERY TRANSVERSE BAR. THE TRANSVERSE SPACING SHALL BE A 48" MAXIMUM. PLACEMENT MAY BE STAGGERED SO THAT CHAIRS IN ALTERNATE ROWS ARE CENTERED BETWEEN THE CHAIRS IN ADJACENT ROWS.
- JOINT GROOVE AND SEAL DETAILS SHALL BE AS SHOWN ELSEWHERE IN THE PLANS.
- LONGITUDINAL AND TRANSVERSE STEEL SPACING SHALL NOT VARY MORE THAN ONE-TWELFTH OF THE SPACING SHOWN HEREON.
- WHEN MACHINE PLACING OF STEEL REINFORCEMENT IS USED, THE USE OF CHAIRS SHALL NOT BE REQUIRED, AND THE TRANSVERSE STEEL MAY BE PLACED EITHER ABOVE OR BELOW THE LONGITUDINAL STEEL.


NOTE: THE SPACINGS (1) SHOWN IN THE ABOVE PLACEMENT TABLE ARE THE MAXIMUM ALLOWABLE SPACINGS. WHERE THE PROPOSED PLACEMENT WIDTHS VARY FROM THE BASIC DESIGN WIDTH SHOWN, THE SPACING (1) AND THE ADJACENT SPACING (2) SHALL BE ADJUSTED TO ACCOMMODATE A REINFORCEMENT ARRANGEMENT EQUAL TO OR SLIGHTLY HEAVIER THAN THAT SHOWN AS DIRECTED BY THE ENGINEER.

- INCLUDES BOTH REGULAR LONGITUDINAL AND TRANSVERSE BARS BASED UPON 1 FOOT PAVEMENT LENGTHS. FOR THE WIDTH INDICATED, ALL TRANSVERSE STEEL IS 4 BARS AT 36" CENTERS. **
- THIS SHALL BE THE MINIMUM NUMBER OF ADDITIONAL STEEL BARS TO BE PLACED PER LANE. THE SPACING OF THE ADDITIONAL STEEL BARS SHALL BE VARIED AS DIRECTED IN ORDER TO PROVIDE A MINIMUM CLEARANCE OF 13/4" FROM EACH REGULAR LONGITUDINAL REINFORCING BAR.

TEXAS HIGHWAY DEPARTMENT CONCRETE PAVEMENT DETAILS CONTINUOUSLY REINFORCED STEEL BARS CPCR (B)-71 (I)


290

DN	DRAWING	DATE	REV	BY	CHK	APP	DATE	NO.	DATE	NO.
DN	ORIGINAL	FEB 1969								
DN	REVISED	DEC 1, 1969	4	TRAB				145-51621-278	290	
TR										
DATE								18 DALLAS	92	14 16 1145

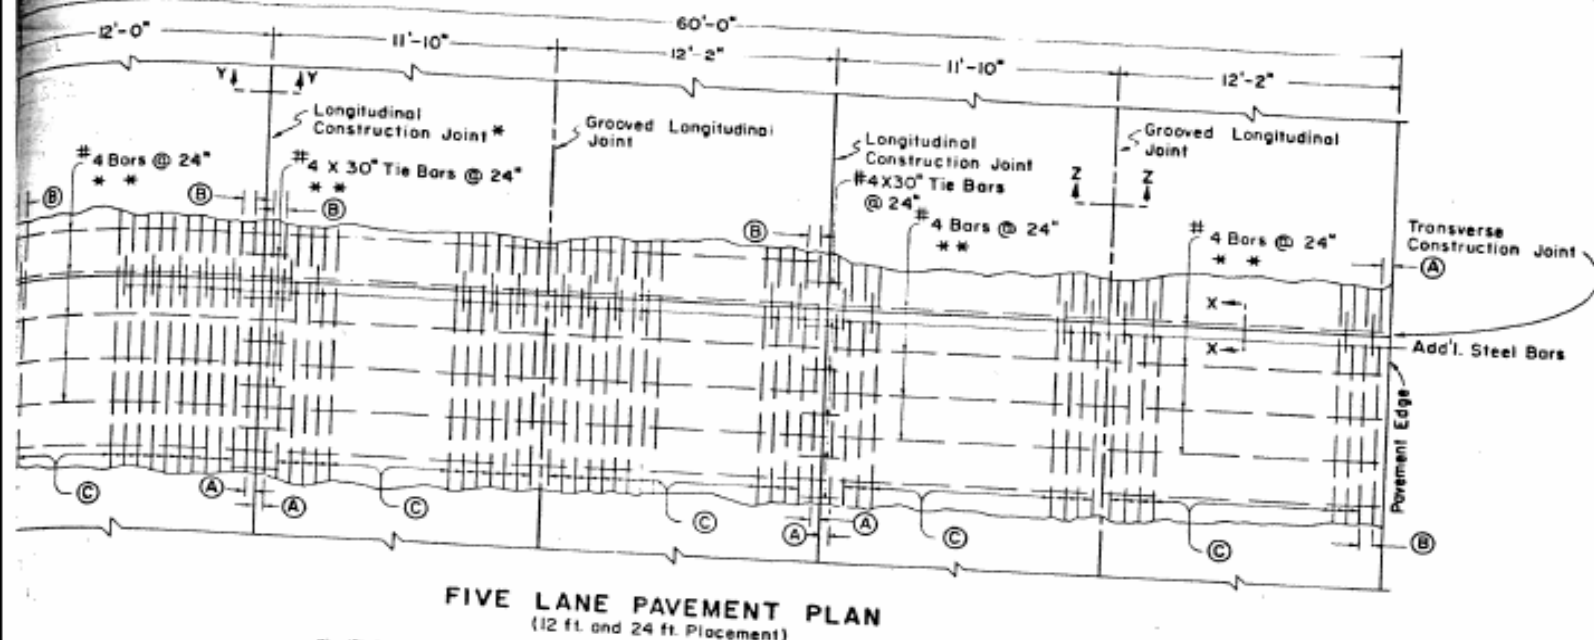


FIVE LANE PAVEMENT PLAN
(12 ft. and 24 ft. Placement)


* WITH THE APPROVAL OF THE ENGINEER, THE CONTRACTOR MAY PLACE THE PAVEMENT THE FULL ROADWAY WIDTH AS ONE PLACEMENT. IF SO PLACED, THE LONGITUDINAL CONSTRUCTION JOINT SHOWN SHALL BE REPLACED BY THE GROOVED LONGITUDINAL JOINT.

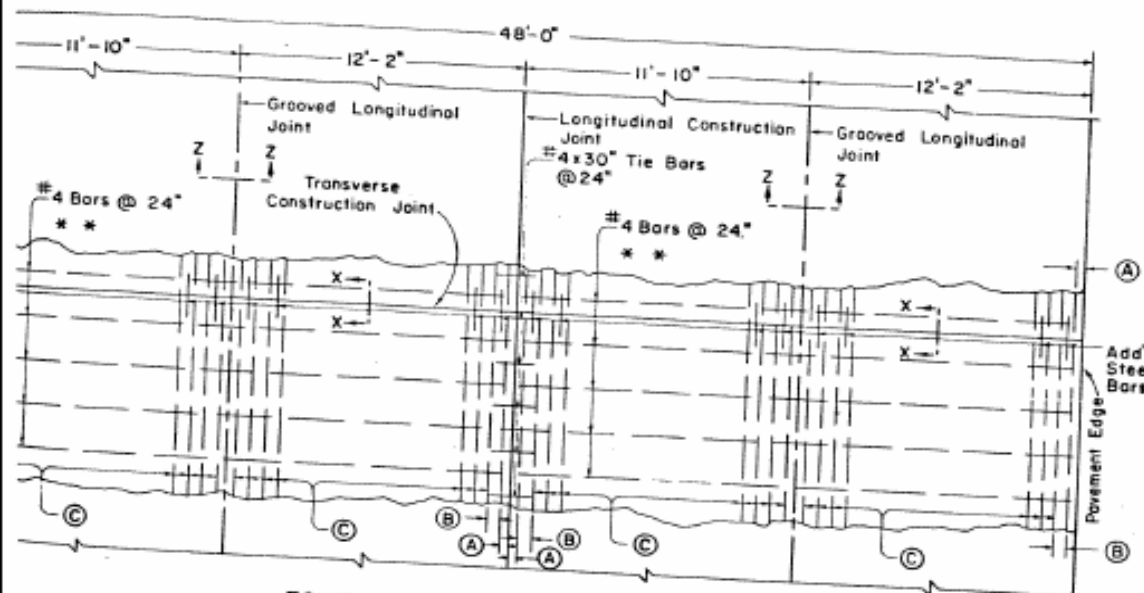


FOUR LANE PAVEMENT PLAN
(24 ft. Placement)

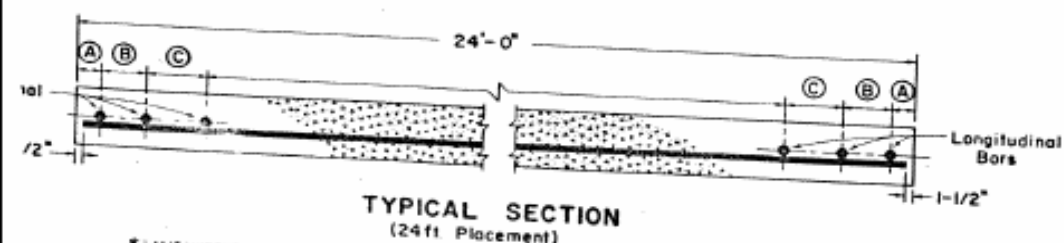


TYPICAL SECTION
(24 ft. Placement)

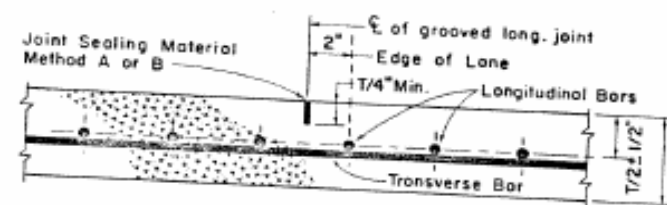

GROOVED LONGITUDINAL JOINT
Section Z-Z

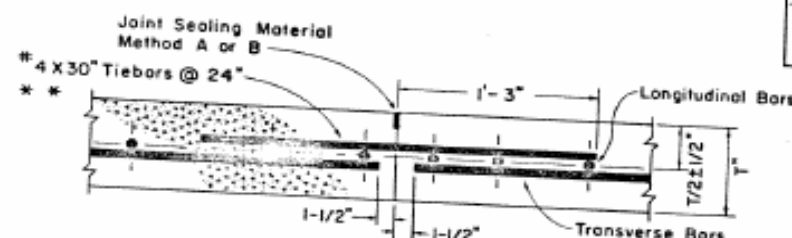

LONGITUDINAL CONSTRUCTION JOINT
Section Y-Y

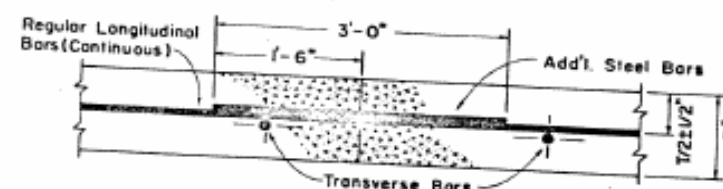

TRANSVERSE CONSTRUCTION JOINT
Section X-X

** SEE DESIGN DETAIL RC (CPCR)-7 FOR STEEL REQUIREMENTS NEAR RAMP CONNECTIONS.

- GENERAL NOTES
- NO EXPANSION JOINTS WILL BE USED EXCEPT AT STRUCTURE ENDS OR FIXED OBJECTS AS SHOWN ELSEWHERE IN THE PLANS.
 - FOR FURTHER INFORMATION REGARDING THE PLACEMENT OF CONCRETE AND REINFORCEMENT, REFER TO THE GOVERNMENT SPECIFICATIONS FOR "CONCRETE PAVEMENT".
 - DETAILS AS TO PAVEMENT WIDTH, PAVEMENT THICKNESS AND THE CROWN CROSS-SLOPE SHALL BE AS SHOWN ELSEWHERE IN THE PLANS.
 - WITHIN ANY AREA BOUNDED BY TWO FEET OF PAVEMENT LENGTH MEASURED PARALLEL TO THE CENTERLINE AND TWELVE FEET OF PAVEMENT WIDTH MEASURED PERPENDICULAR TO THE PAVEMENT CENTERLINE, NOT OVER 33% OF THE REGULAR LONGITUDINAL STEEL SHALL BE SPICED.
 - LONGITUDINAL AND TRANSVERSE BARS SHALL BE STEEL CONFORMING TO ASTM A-615 OR ASTM A-616 (GRADE 60) AS NOTED IN THE SPECIFICATIONS.
 - SPICES SHALL BE A MINIMUM OF 24 TIMES THE NOMINAL DIAMETER OF THE BAR.
 - BARS OF ASTM DESIGNATIONS: A-615 OR A-616, GRADE 60 STEEL SHALL NOT BE BENT. IF THE CONTRACTOR ELECTS TO BEND THE TIEBARS, THEY SHALL BE STEEL CONFORMING TO ASTM DESIGNATIONS: A-615, GRADE 60 AND SPACED 22" C-C, FOR 37' TO 60' PAVEMENT WIDTH.
 - AT TRANSVERSE CONSTRUCTION JOINTS THE REGULAR LONGITUDINAL BARS SHALL EXTEND BEYOND THE JOINT SO THAT THE BAR SPICES FOR THE REGULAR LONGITUDINAL BARS SHALL BE A MINIMUM OF FOUR FEET FROM THE CONSTRUCTION JOINT. AT LONGITUDINAL CONSTRUCTION JOINTS IF THE CONTRACTOR ELECTS TO CONTINUE THE REGULAR TRANSVERSE STEEL THROUGH THE JOINT, THE #4 TIEBARS SHOWN HEREON MAY BE DELETED. VIBRATION JOINTS.
 - WITH THE APPROVAL OF THE ENGINEER, MULTIPLE PIECE TIEBARS (THREADED COUPLING OR OTHER ADEQUATE DEVICE) MAY BE USED TO FACILITATE CONSTRUCTION PROVIDED THE SYSTEM DEVELOPS A FORCE EQUAL TO 1 1/2 TIMES THE MINIMUM YIELD FORCE OF THE TIEBAR SHOWN. THE SPACINGS FOR THE SYSTEM SHALL BE LESS THAN OR EQUAL TO THE SPACING ALLOWED FOR BARS OF SIMILAR YIELD STRENGTH.
 - THE CHAIRS USED TO SUPPORT THE BAR MAT SHALL BE OF SUFFICIENT STRUCTURAL QUALITY AND NUMBER TO HOLD THE MAT WITHIN THE PLACEMENT HEIGHT TOLERANCES, AND SHALL BE OF A TYPE APPROVED BY THE ENGINEER.
 - IN THE NORMAL 24" PLACEMENT FOR THE TRANSVERSE BARS, CHAIRS SHALL BE PLACED UNDER EVERY TRANSVERSE BAR. THE TRANSVERSE SPACING SHALL BE A MAXIMUM. PLACEMENT MAY BE STAGGERED SO THAT CHAIRS IN ALTERNATE ROWS ARE CENTERED BETWEEN THE CHAIRS IN ADJACENT ROWS.
 - JOINT GROOVE AND SEAL DETAILS SHALL BE AS SHOWN ELSEWHERE IN THE PLANS.
 - LONGITUDINAL AND TRANSVERSE STEEL SPACING SHALL NOT VARY MORE THAN ONE-TWELFTH OF THE SPACING SHOWN HEREON.
 - WHEN MACHINE PLACING OF STEEL REINFORCEMENT IS USED, THE USE OF CHAIRS WILL NOT BE REQUIRED, AND THE TRANSVERSE STEEL MAY BE PLACED EITHER ABOVE OR BELOW THE LONGITUDINAL STEEL.

REINFORCEMENT REQUIRED, AND																
BE REINFORCED, AND																
BE REINFORCED, AND																
Per Cent Long Steel	Pavement Thickness "ft. in.	Bar Size	24 ft. Placement Width				12 ft. Placement Width				Add'l. Steel in Trans. Const. J.					
			Spacing c/c			No. of Bars	Steel #/sq ft	Spacing c/c			No. of Bars	Steel #/sq ft	Size	No. per 24' place. width	No. per 12' place. width	Weight #/sq. ft. based on 12' place.
in	in	in	in	in	in			in								
0.5	10	No. 6	3	5	8.5	35	22.72	3	5.25	8.5	18	23.28	3/4"x36"	18	9	3.38
	9	No. 5	3	4.5	6.5	45	20.61	3	4	6.5	23	21.00	5/8"x36"	22	11	2.87
	8	No. 5	3	6	7.5	39	18.26	3	5.25	7.5	20	18.65	5/8"x36"	20	10	2.61
	7	No. 5	3	5	8.5	35	16.70	4	8.5	17	16.30	5/8"x36"	18	9	2.35	
	6	No. 4	3	4.5	7	42	13.53	3	6	7	21	13.53	1/2"x36"	20	11	1.84
0.6	10	No. 6	3	7	7.25	46	15.58	3	7.25	7.25	16	15.52	3/4"x36"	20	10	3.76
	9	No. 6	3	5	8	37	13.05	3	5	8	19	14.41	3/4"x36"	19	10	3.76
	8	No. 5	3	6.25	6.25	44	11.00	3	6.25	6.25	24	11.76	3/8"x36"	23	11	2.87
	7	No. 5	3	7	7.25	40	10.65	3	7.25	7.25	20	10.65	5/8"x36"	20	10	2.61
	6	No. 5	3	5	8.5	35	16.70	3	5.25	8.5	16	17.09	5/8"x36"	16	9	2.35


NOTE: THE SPACINGS (B) SHOWN IN THE ABOVE PLACEMENT TABLE ARE THE MAXIMUM ALLOWABLE SPACINGS. WHERE THE PROPOSED PLACEMENT WIDTHS VARY FROM THE BASIC DESIGN WIDTH SHOWN, THE SPACING (B) AND THE ADJACENT SPACING (C) SHALL BE ADJUSTED TO ACCOMMODATE A REINFORCEMENT ARRANGEMENT EQUAL TO OR SLIGHTLY HEAVIER THAN THAT SHOWN AS DIRECTED BY THE ENGINEER.

- INCLUDES BOTH REGULAR LONGITUDINAL AND TRANSVERSE BARS BASED UPON 1 FOOT PAVEMENT LENGTHS FOR THE WIDTH INDICATED. ALL TRANSVERSE STEEL IS #4 BARS.
- THIS SHALL BE THE MINIMUM NUMBER OF ADDITIONAL STEEL BARS TO BE PLACED PER LANE. THE SPACING OF THE ADDITIONAL STEEL BARS SHALL BE VARIED AS DIRECTED IN ORDER TO PROVIDE A MINIMUM CLEARANCE OF 1'-3/4" FROM EACH REGULAR LONGITUDINAL REINFORCING BAR.


TEXAS HIGHWAY DEPARTMENT
CONCRETE PAVEMENT DETAILS
CONTINUOUSLY REINFORCED
STEEL BARS

CPCR (B)-71 (2)


291

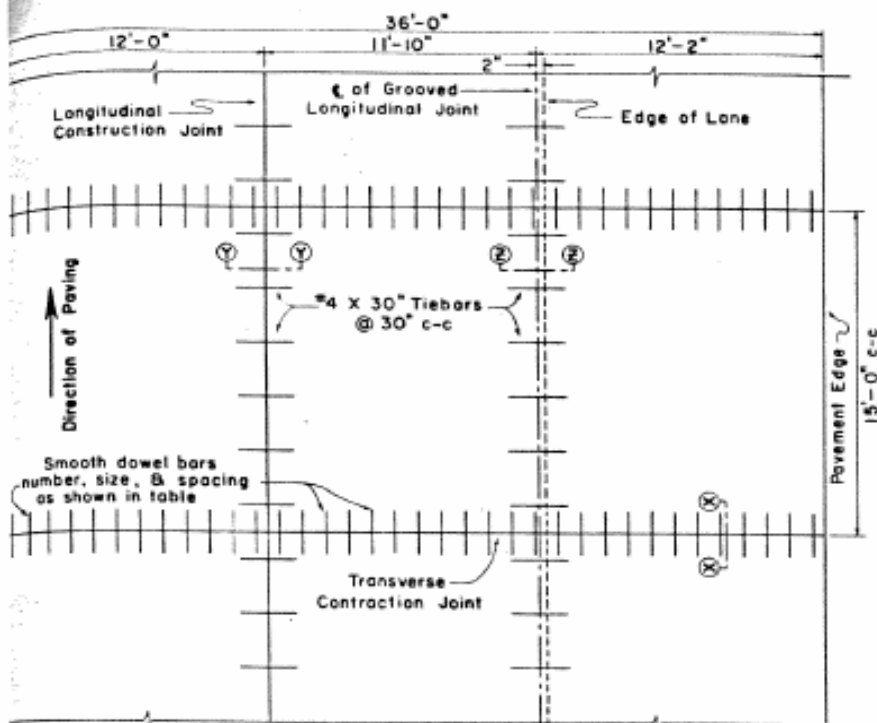



THREE LANE PAVEMENT PLAN
(12 ft. & 24 ft. Placement)*

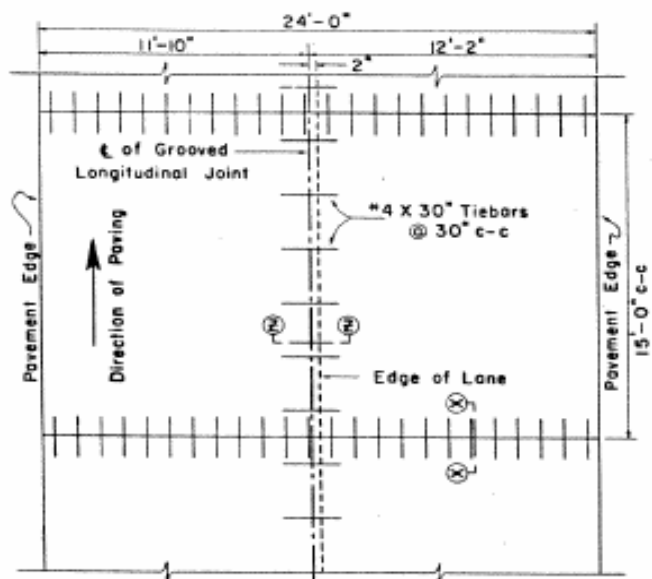


TWO LANE PAVEMENT PLAN

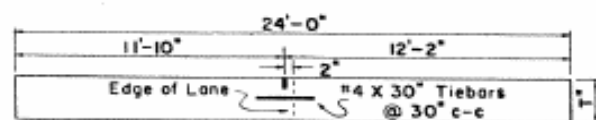

TYPICAL SECTION
(24 ft. Placement)*

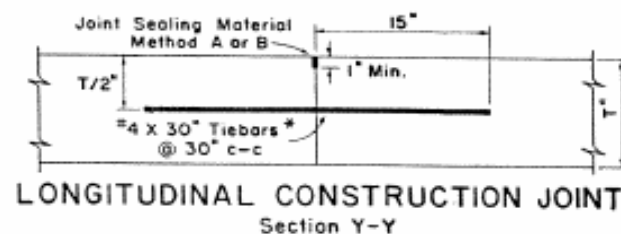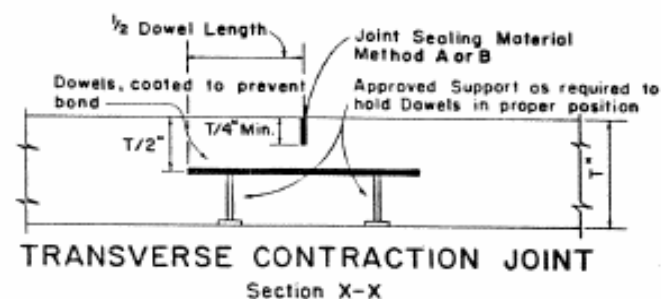

*WITH THE APPROVAL OF THE ENGINEER, MULTIPLE-PIECE TIEBARS (THREADED COUPLING OR OTHER ADEQUATE DEVICE) MAY BE USED TO FACILITATE CONSTRUCTION PROVIDED THE SYSTEM DEVELOPS A FORCE EQUAL TO 1 1/2 TIMES THE MINIMUM FORCE OF THE TIEBAR SHOWN. THE SPACINGS FOR THE SYSTEM SHALL BE LESS THAN OR EQUAL TO THE SPACING ALLOWED FOR BARS OF SIMILAR YIELD STRENGTH.

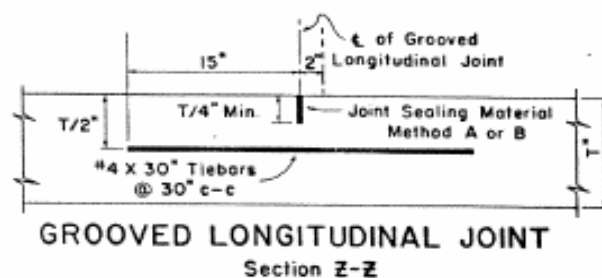

* Lane widths are for illustrative purposes only and should not be used if in conflict with typical cross sections shown elsewhere in the plans.

GENERAL NOTES

- NO EXPANSION JOINTS WILL BE USED EXCEPT AT STRUCTURE ENDS OR FIXED OBJECTS AS SHOWN ELSEWHERE IN THE PLANS.
- FOR FURTHER INFORMATION REGARDING THE PLACEMENT OF CONCRETE AND LOAD TRANSFER DEVICES REFER TO THE GOVERNING SPECIFICATIONS FOR "CONCRETE PAVEMENT".
- DETAILS AS TO PAVEMENT WIDTH, PAVEMENT THICKNESS, AND THE CROWN CROSS-SLOPE SHALL BE AS SHOWN ELSEWHERE IN THE PLANS.
- JOINT GROOVE AND SEAL DETAILS SHALL BE AS SHOWN ELSEWHERE IN THE PLANS.
- TIEBARS SHALL BE SECURED PARALLEL TO THE PAVEMENT SURFACE AND PERPENDICULAR TO THE CENTERLINE BY:
 - USE OF BAR CHAIRS
 - ACCURATELY PLACED IN POSITION ON THE SCAFFOLD CONCRETE BY MEANS OF AN APPROVED TEMPLATE AND FORCED TO THE PROPER POSITION WITH A SUITABLE TOOL, OR
 - BY ANY OTHER MEANS WHICH, PRIOR TO ITS USE, HAS BEEN APPROVED BY THE ENGINEER.
- DOWEL BARS SHALL BE SECURED PARALLEL TO THE PAVEMENT SURFACE AND CENTERLINE BY A DOWEL BAR CHAIR.
- WHEN WORK IS STOPPED DUE TO BREAKDOWN OR OTHER CAUSE, CONCRETE SHALL BE REMOVED BEYOND LAST CONTRACTION JOINT IN PLACE AND A HEAVYER INSTALLED.
- WHERE A MONOLITHIC CURB IS SPECIFIED, THE JOINT IN THE CURB SHALL COINCIDE WITH PAVEMENT JOINTS AND MAY BE FORMED BY ANY MEANS WHICH, PRIOR TO ITS USE, HAS BEEN APPROVED BY THE ENGINEER.
- CONSTRUCTION JOINTS MAY BE FORMED BY USE OF METAL OR WOOD FORMS EQUAL IN DEPTH TO THE NOMINAL DEPTH OF THE PAVEMENT, OR BY OTHER MEANS WHICH HAVE BEEN APPROVED BY THE ENGINEER PRIOR TO THEIR USE.
- LONGITUDINAL AND TRANSVERSE STEEL SPACING SHALL NOT VARY MORE THAN ONE TWELFTH OF THE SPACING SHOWN HEREON.
- THE TIEBAR SPACINGS SHOWN ARE FOR ASTM DESIGNATIONS: A-615, OR A-616, GRADE 60, TIEBARS, WHICH SHALL NOT BE BENT. IF TIEBARS ARE TO BE BENT, THEY SHALL BE STEEL CONFORMING TO ASTM DESIGNATION: A-615, GRADE 40, WITH A CENTER TO CENTER SPACING OF 24 INCHES.
- SEE KC (CPCD)-71 FOR STEEL PLACING REQUIREMENTS IN THE AREA OF CONFLUENCE AT RAMP TERMINALS.

DEPTH OF PAVEMENT (INCHES)	DOWELS (SMOOTH BARS)		
	SIZE AND LENGTH	AVERAGE SPACING (INCHES)	WEIGHT PER FOOT OF JOINT (LBS.)
8	1" X 18"	12	4.01
9	1 1/8" X 20"	12	5.63
10	1 1/4" X 22"	12	7.65
11	1 1/2" X 24"	12	10.10






TEXAS HIGHWAY DEPARTMENT
CONCRETE PAVEMENT DETAILS
CONTRACTION DESIGN
CPCD-71 (Rev.)

292

DATE	DRAWING	DATE	REV.	STATUS	FEDERAL PROJECT NO.	SHEET
10/1/69	ORIGINAL	10/1/69	1	AS BUILT	145-3-621278	292
10/1/69						
10/1/69						
10/1/69						

GENERAL NOTES

- FOR FURTHER INFORMATION REGARDING THE PLACEMENT OF CONCRETE AND REINFORCEMENT REFER TO THE GOVERNING SPECIFICATION FOR CONCRETE PAVEMENT.
- RAMP DETAILS ARE TYPICAL ONLY. GEOMETRIC DETAILS AS TO ALIGNMENT, PAVEMENT WIDTH, PAVEMENT THICKNESS, AND THEREAFTER CROSS SLOPE SHALL BE AS SHOWN ELSEWHERE IN THE PLANS.
- THE DESIGN REQUIREMENTS FOR THE PAVEMENT STRUCTURE, I.E., BAR SPACING, BAR SIZE, LAP REQUIREMENTS, ETC., SHALL BE AS SHOWN ON THE APPROPRIATE CPCR DESIGN DETAIL.
- IF THE CONTRACTOR ELECTS TO CONTINUE THE REGULAR TRANSVERSE STEEL THROUGH THE JOINT AT THE LONGITUDINAL CONSTRUCTION JOINTS, THE NUMBERS AROUND TIEBARS AS SHOWN HEREON MAY BE DELETED. THE LOCATION OF THE RAMP SHALL BE AS SHOWN ELSEWHERE IN THE PLANS.
- THE SEQUENCE OF OPERATION IN PLACING THE RAMP SHALL BE AS DIRECTED BY THE ENGINEER. THE LONGITUDINAL STEEL SHALL BE PLACED IN A DIRECTION, APPROXIMATELY PARALLEL TO THE DIRECTION OF THE RAMP.
- LONGITUDINAL AND TRANSVERSE STEEL SPACING SHALL NOT VARY MORE THAN ONE TWELFTH OF THE SPACING SHOWN HEREON.
- IN THE AREA OF CONFLUENCE TRANSVERSE BARS AND TIE BARS (MAIN LANES AND RAMP) WILL BE #5 BARS WITH SPACING SAME AS THAT IN STANDARD FOR ROADWAY.

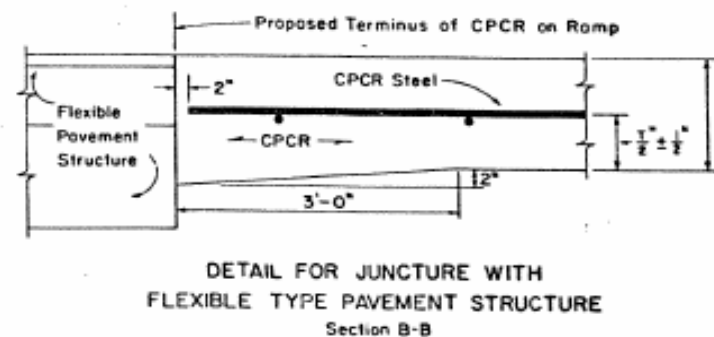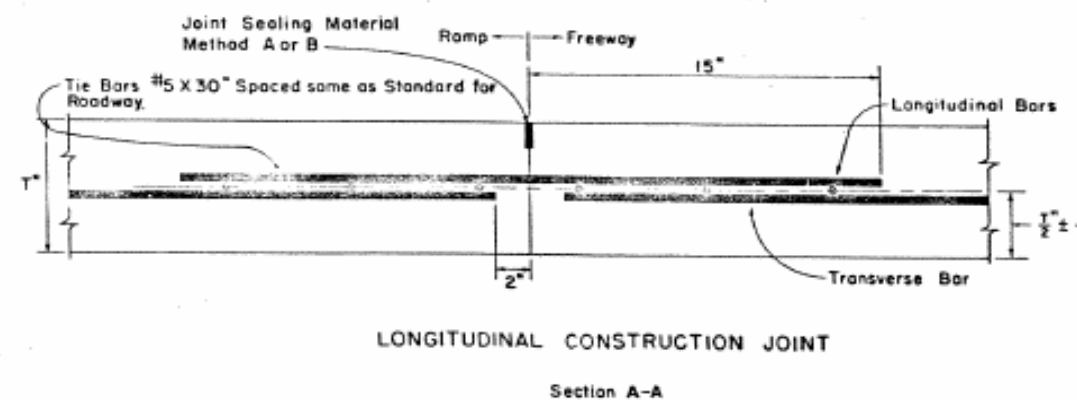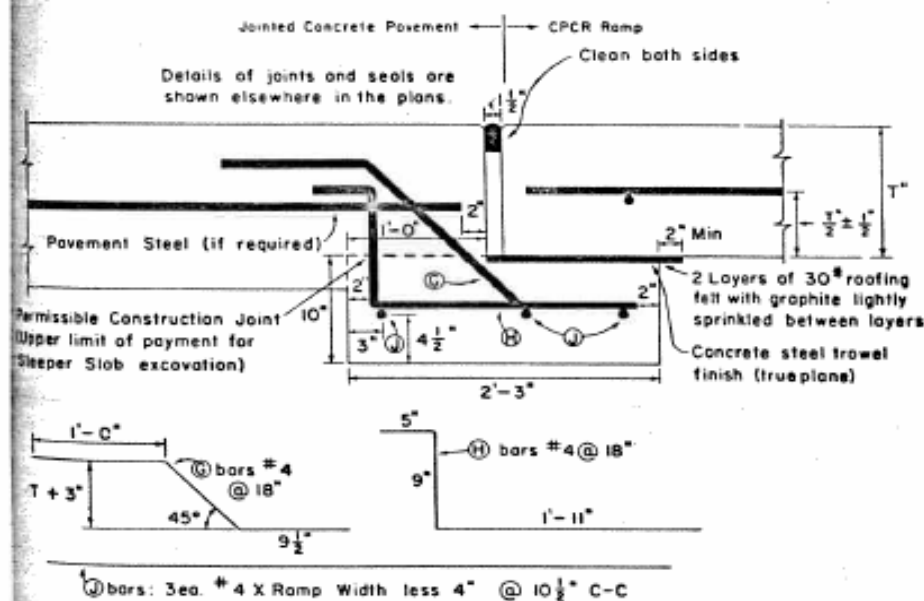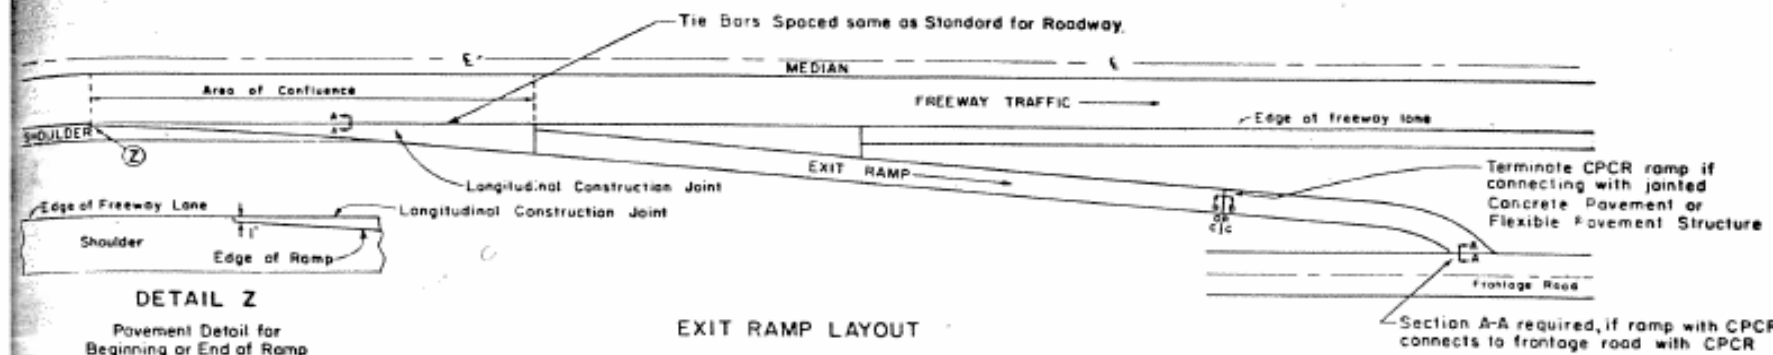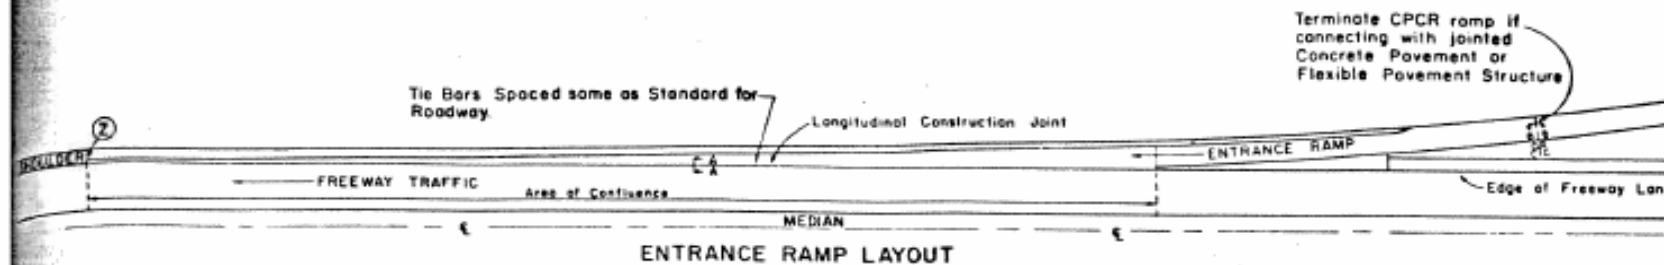

RAMP TERMINUS DETAIL FOR JUNCTURE WITH JOINTED CONCRETE PAVEMENT STRUCTURE
Section C-C

TEXAS HIGHWAY DEPARTMENT RAMP CONNECTIONS FOR CONCRETE PAVEMENT CONTINUOUSLY REINFORCED

RC (CPCR)-71 (REV) 293

NO.	DATE	BY	CHKD BY	DATE	PROJECT NO.	SHEET NO.
1	1969	W	W	1969	145-3(62)278	293
2						
3						
