

GREEN

SH 347 667-1-8
Return to
Dist. Office


SHEET NO.	DESCRIPTION
1	TITLE SHEET
2	TYPICAL CROSS SECTIONS
3 & 3-A	ESTIMATE AND QUANTITY
4-6	PLAN PROFILE
7	LOCATION OF MATERIAL SOURCES
8	INTERSECTION LAYOUT SHEET
9	DRAINAGE LAYOUT
10-13	STRUCTURAL DETAILS & STANDARDS
10	CATCH BASIN & CURB DETAILS
11	CONCRETE PAVEMENT (SPL. DESIGN)
12-13	BW-46 (1&2)

STATE OF TEXAS STATE HIGHWAY DEPARTMENT PLANS OF COMPLETED STATE HIGHWAY IMPROVEMENT

STATE PROJECT C667-1-8
JEFFERSON COUNTY
STATE HIGHWAY 347

PLAN: 1 IN. = 100 FT.
PROFILE: 1 IN. HOR. = 100 FT., 1 IN. VERT. = 5 FT.
CROSS-SECTIONS: 1 IN. HOR. AND VERT. = 5 FT.
OTHERS AS NOTED.
NET LENGTH OF PROJECT = 4,169.5 FT. = 0.789 MI.

FROM NEAR SOUTH CITY LIMITS OF NEDERLAND TO 0.1 MILE NORTH OF KOLEMAY ROAD
CONCRETE PAVEMENT & DRAINAGE STRUCTURES

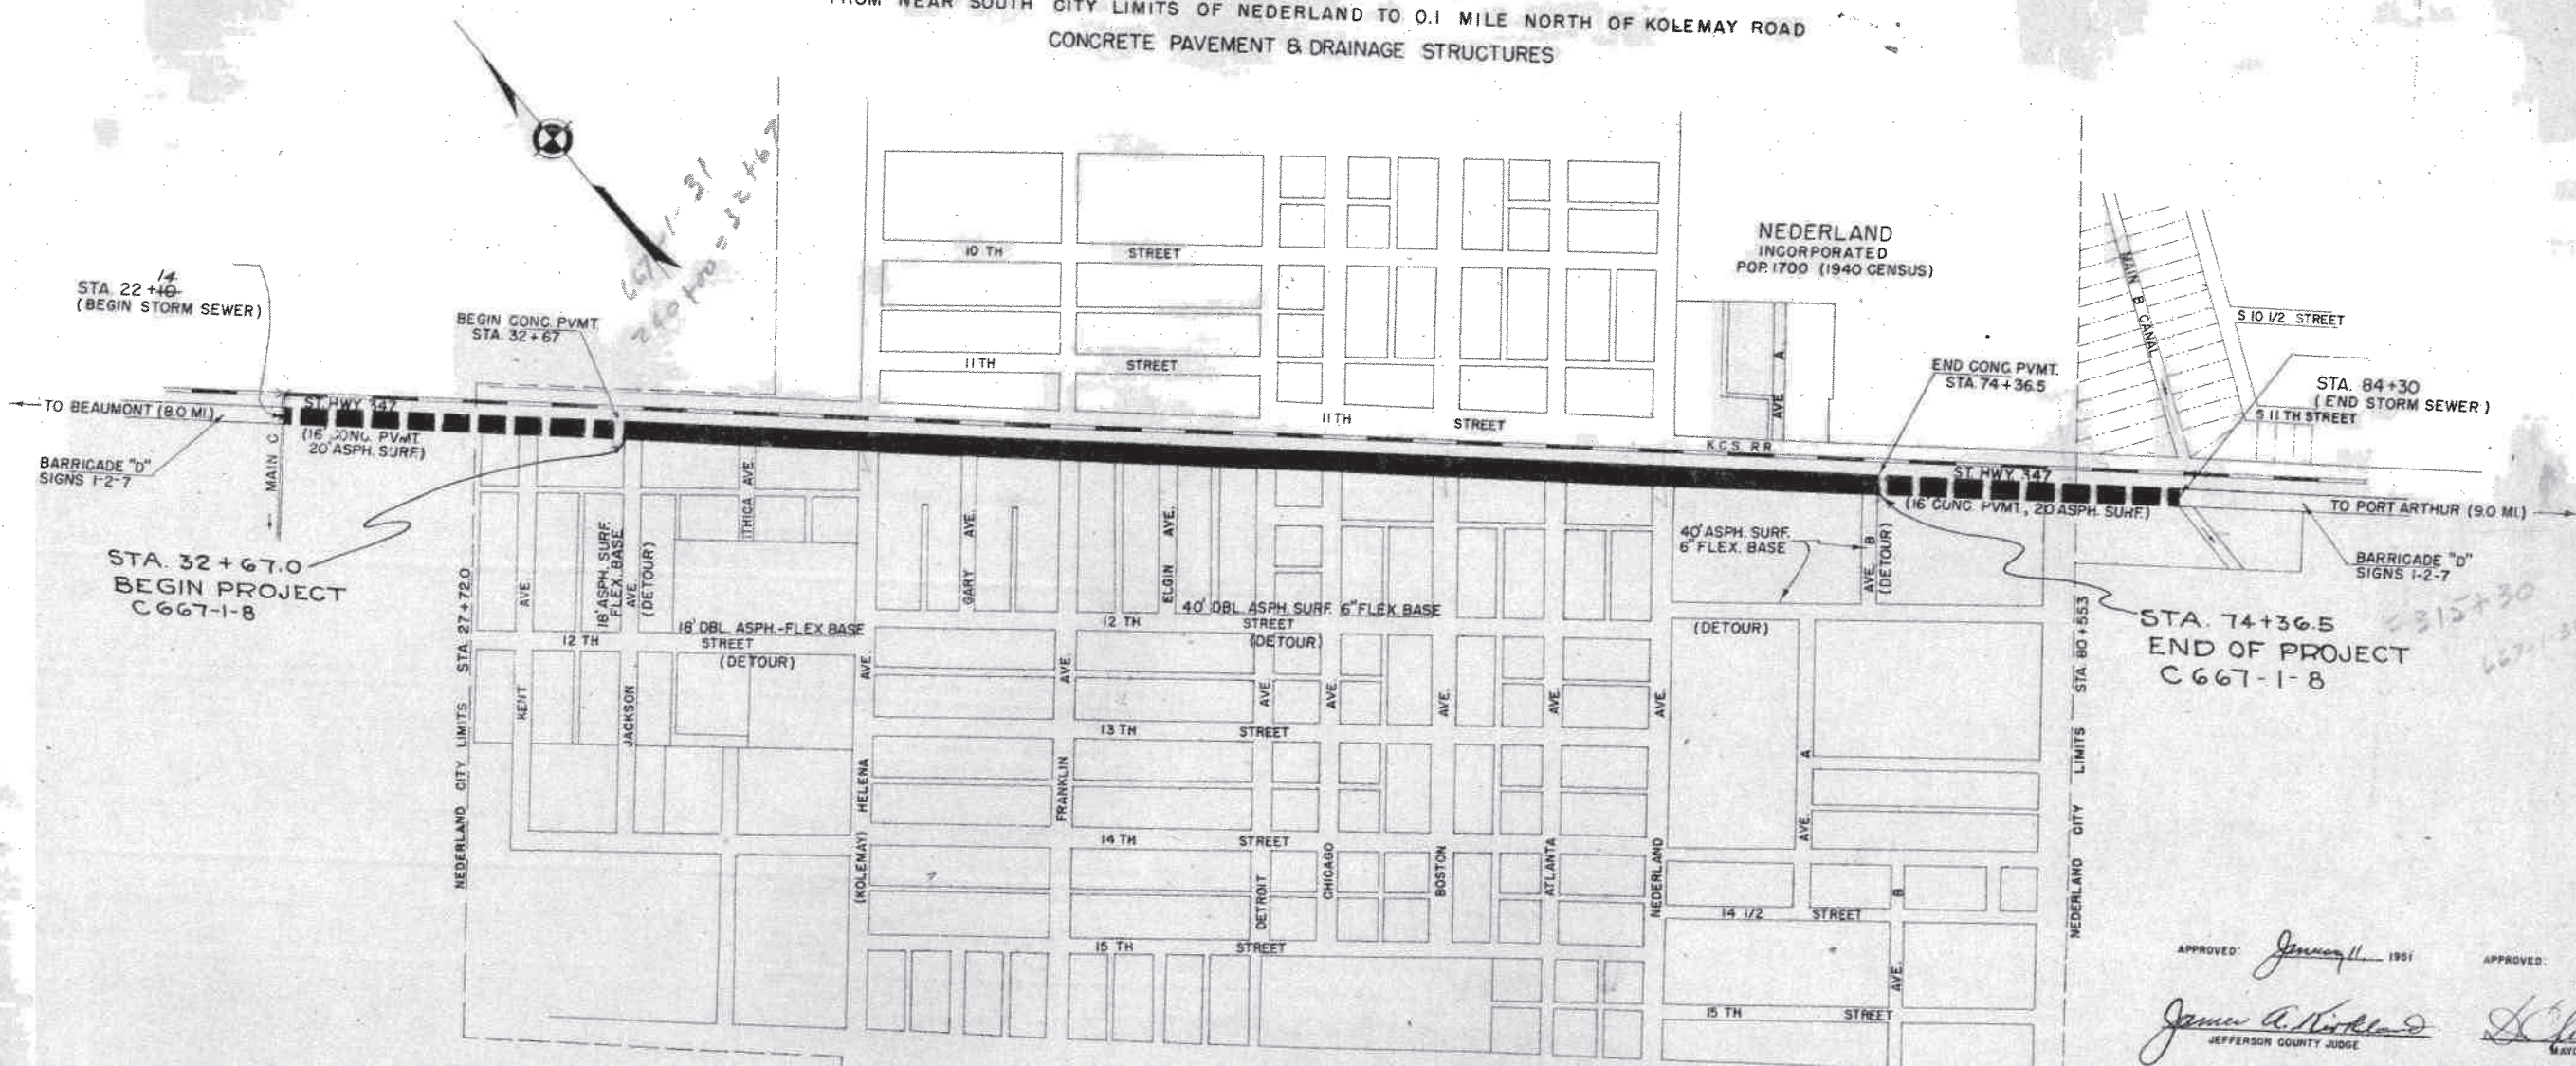

CONVENTIONAL SIGNS

STATE OR NATIONAL LINE	[Symbol]
CITY OR VILLAGE LINE	[Symbol]
COUNTY LINE	[Symbol]
BASE OR SURVEY LINE	[Symbol]
RIGHT OF WAY LINE	[Symbol]
RIGHT OF WAY MARKERS	[Symbol]
FENCE LINE	[Symbol]
RAILROAD	[Symbol]
TRAVELLED WAY	[Symbol]
CULVERT OR BRIDGE	[Symbol]
POWER LINE	[Symbol]
TELEGRAPH OR TELEPHONE	[Symbol]

LOCATION	MATERIAL RAILROAD	DELIVERY POINTS DIST TO PROJ.	CAPACITY
NEDERLAND	K.C.S.	0.0 MI.	AMPLE
PT. NECHES	K.C.S.	2.0 MI.	AMPLE

NO EXCEPTIONS
NO EQUATIONS
NO RAILROAD CROSSINGS INVOLVED

SPECIFICATIONS LISTED AND DATED AS FOLLOWS: SHALL GOVERN ON THIS PROJECT:
SPECIAL LABOR PROVISIONS FOR STATE PROJECTS ADOPTED AUGUST 11, 1948
TEXAS HIGHWAY DEPARTMENT SPECIFICATIONS AS REVISED BY MARCH 1950
ISSUE WITH MODIFICATIONS.

PROJECT CONSTRUCTED AND FINAL
PLANS PREPARED BY
Martha Swain
RESIDENT ENGINEER

LAYOUT SCALE: 1 IN. = 300 FT.

STATE HIGHWAY DEPARTMENT

CORRECT: 1-11-1951

RECOMMENDED FOR APPROVAL: 1-31-1951

APPROVED: *James A. Kirkland* JEFFERSON COUNTY JUDGE


APPROVED: *James H. 1951*

RECOMMENDED FOR APPROVAL: *W.E. Smothers* DISTRICT ENGINEER


RECOMMENDED FOR APPROVAL: [Signature] BRIDGE ENGINEER

RECOMMENDED FOR APPROVAL: [Signature] DISTRICT ENGINEER


APPROVED: [Signature] CHIEF ENGINEER OF PLANNING

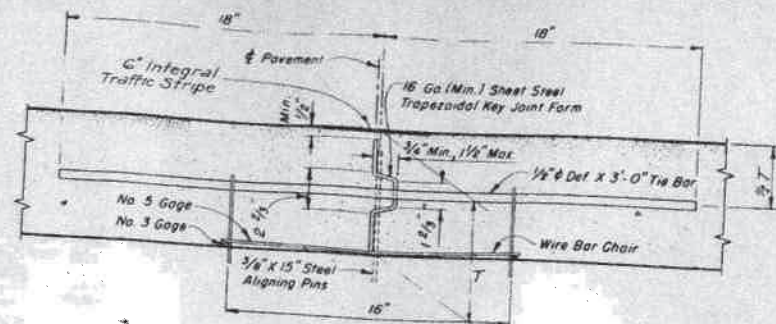

TYPE 1 - STEEL TONGUE-AND-GROOVE FORM

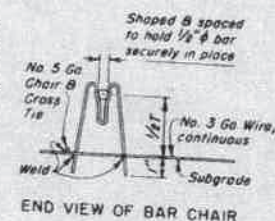


END VIEW OF BAR CHAIR

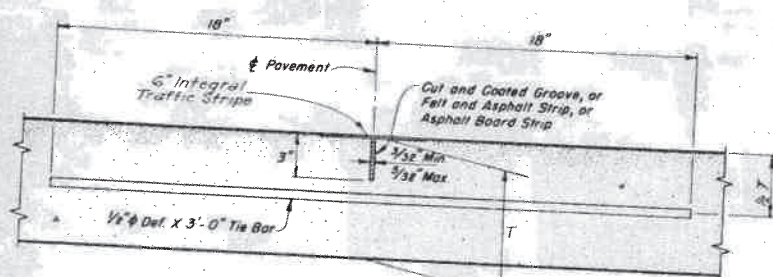

TYPE 2 - MACHINE CUT GROOVE

The groove shall be cut by an approved machine and the vertical faces of the concrete coated with an approved concrete curing compound before closing and final finishing, or a 1/16" asphalt impregnated felt strip shall be inserted, continuous between expansion joints, or an asphalt board strip held in an approved continuous metal shield, shall be placed continuously in a groove cut in the concrete by an approved mechanical device operated in advance of the longitudinal float. The strips or groove shall be true to line, vertical, and of the depth shown. Tie bars shall be installed as in Type 1, or accurately placed in position on the screeded concrete by means of an approved template and forced to the proper position with a suitable tool.

ALTERNATE TYPES OF LONGITUDINAL JOINTS

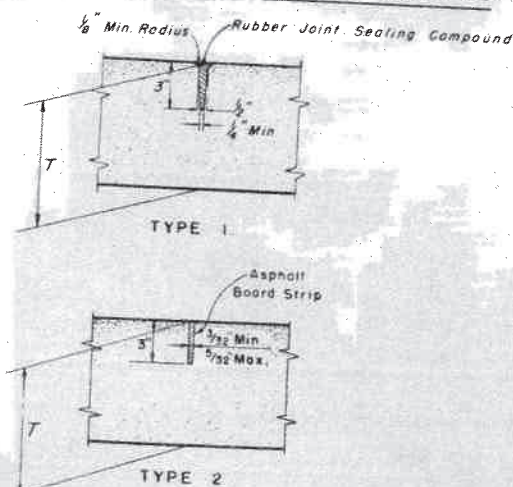


ALTERNATE TYPES OF TRANSVERSE JOINTS


GENERAL NOTES

The asphalt board strip, held in an approved continuous metal shield, shall be placed continuously in a groove cut by an approved mechanical device operating in advance of the longitudinal float.

Either of the alternate types of joints shown by these details may be constructed, at the option of the Contractor if the Contractor desires to use any other device, he shall, prior to its use, secure its approval by the Engineer.

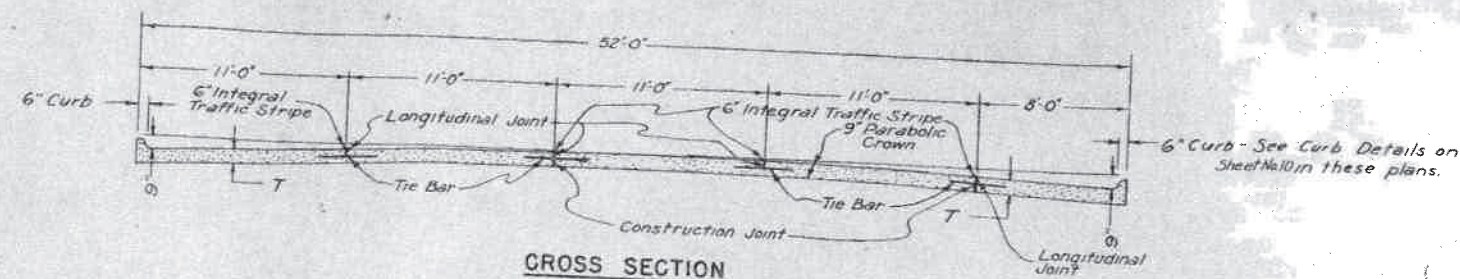

CROSS SECTION

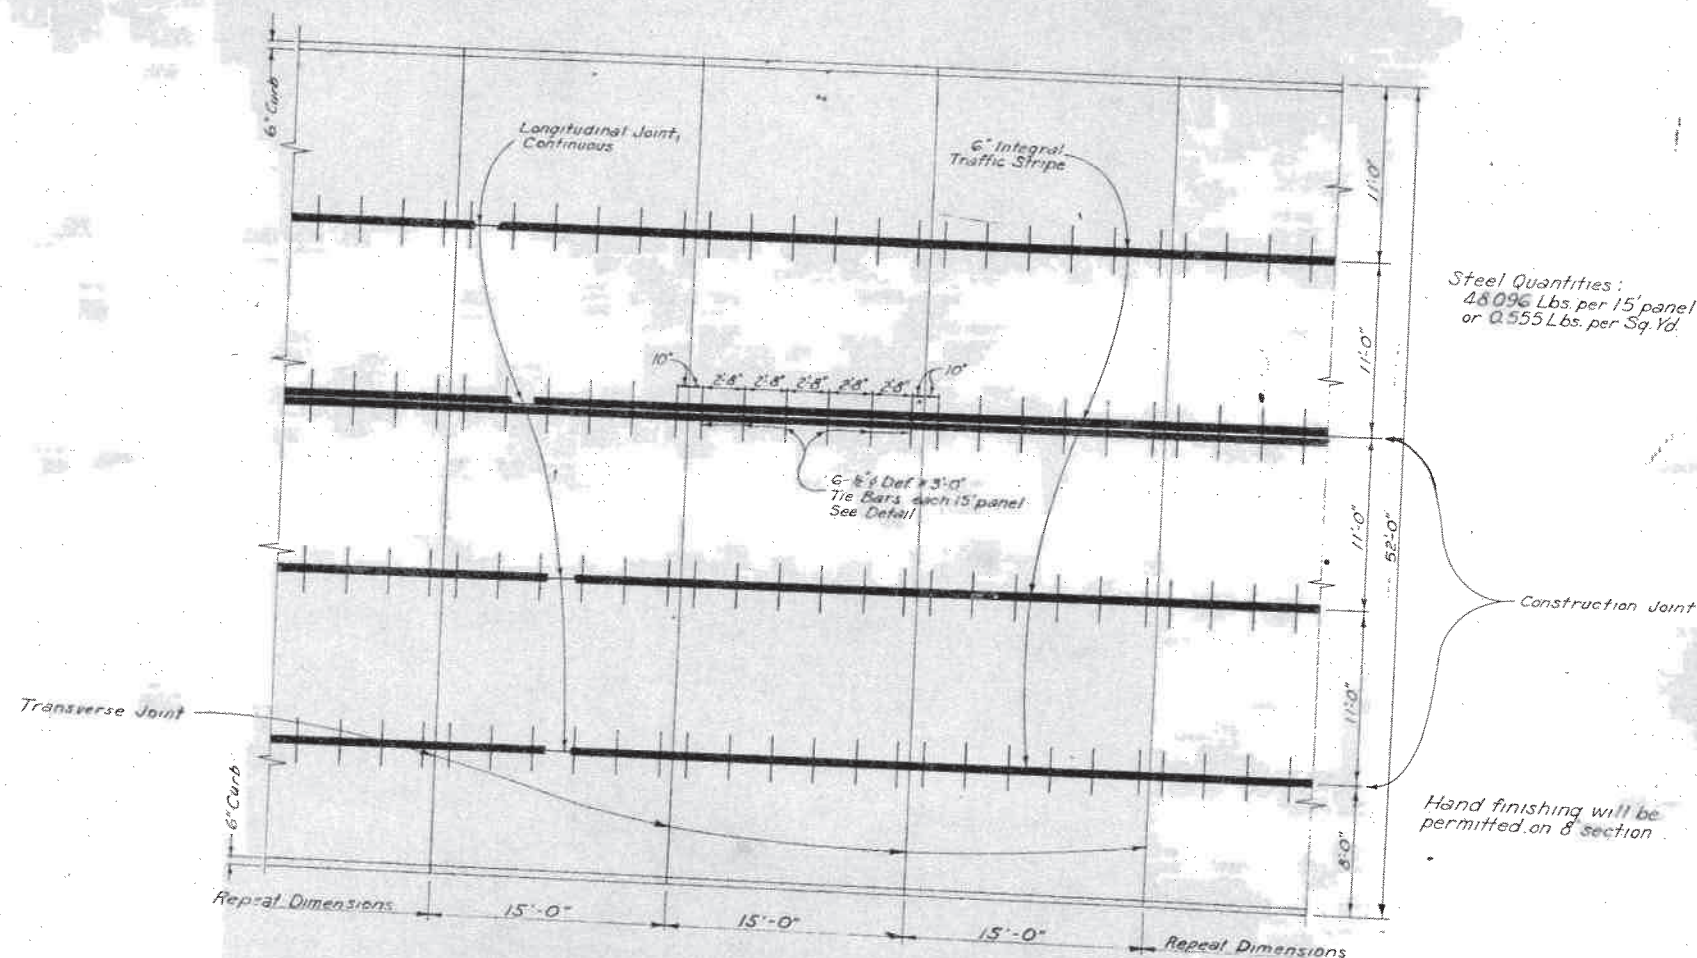

PLAN VIEW

GENERAL NOTES: The Contractor shall install sufficient stakes, braces, brackets, or other devices as necessary to keep the joints true to the required lines and grades and shall leave in place such of these devices as necessary to keep the joints in this position.

All joints, including all materials, devices, and work required shall be considered subsidiary work and shall be included in the unit price bid for "Concrete Pavement." No direct payment will be made for any material, bar chair, steel, or any other device shown, nor for its installation.

At each bridge end construct a thickened and reinforced approach slab as detailed on another sheet in these plans. Additional work, concrete and steel shall be included in unit price bid for "Concrete Pavement."

The furnishing of all material and the installation of all reinforcing steel, tie bars, joints, including load transmission units or dowels and sleeves, and all dowel or bar chairs, shall be subsidiary work and shall be included in the unit price bid for "Concrete Pavement."

Integral Traffic Stripe shall be applied as required by plans and governing specifications. Provisions for use of this patented device have been made by the State free of royalty charges to the Contractor.

Steel quantities are for information of bidders. No direct payment will be made for reinforcing steel.

At the end of each days run, or when work is stopped, place header and install 1/2" def. by 3' long deformed tie bars on 6" centers (See longitudinal joint for details of tie bar.) "T" indicates thickness of pavement as shown on Typical Sections and for E & Q sheets.

The Contractor shall hold and save the State, its officers, its agents, and its employees harmless to liability of any nature or kind, including costs and expenses, for or on account of any patent or unpatented invention, article or appliance manufactured or used in accordance with the details of these plans.

TEXAS HIGHWAY DEPARTMENT CONCRETE PAVEMENT

SPECIAL DESIGN

APPROVED	ENGINEER OF ROAD DESIGN	STATE	PROJECT NO.
REVISED		TEXAS	
		COUNTY	
		20 JEFFERSON	667 1 8 ST.