

US90, 28-07-24  
25  
28-06-24

FED. ROAD DIST. NO.	STATE	FEDERAL AID PROJ. NO.
6	TEXAS	U.S. 90
STATE DIST. NO.	COUNTY	CONT.
20	JEFFERSON	28-7

STATE OF TEXAS  
STATE HIGHWAY DEPARTMENT  
PLANS OF COMPLETED  
STATE HIGHWAY IMPROVEMENT

CLASS 4L HIGHWAY  
DESIGN SPEED: 60 MPH.

INDEX OF SHEETS


SHEET NO.	DESCRIPTION
1	TITLE SHEET
2	GENERAL LAYOUT
3-6	TYPICAL SECTIONS
7-8	SUMMARY OF MANHOLES, INLETS & LATERALS
9	STRUCTURE SUMMARY
10-11	ESTIMATE & QUANTITY
12-15	SPECIFICATION & DATA
16-29	PLAN PROFILE, ETC.
30	WIDENING DETAILS
31	INTERSECTION DETAILS
32-33	INTERSECTION LAYOUT - F.M. 364 & U.S. HWY. 90
34	CONTOUR LAYOUT - F.M. 364 & U.S. HWY. 90
35-36	DRIVEWAY LAYOUTS
37	DRAINAGE AREA MAP (STORM SEWER)
38-40	RUNOFF, INLET & STORM SEWER COMPUTATIONS
41	DRAINAGE AREA MAP (BRIDGE & CULVERT)
42-45	INLET & MANHOLE DETAILS
46-47	23rd STREET CULVERT DETAILS
48-50	LANGHAM RD. DITCH CULVERT DETAILS
51	MC 8-1
52	MCW P-1
53	SIPHON DETAILS
54-56	CONCRETE PAVEMENT DETAILS - CPJR (F) - 61 MOD. & CPJR (B) - 61 MOD. & TA (CPJ) - 61 MOD. BRIDGE LAYOUTS & STRUCTURAL DETAILS:
57-60	HILLEBRANDT BAYOU BRIDGE WIDENING
61-65	CALDWELL CUTOFF BRIDGE WIDENING
66-68	PINCHBACK OUTFALL CHANNEL BRIDGE
69-70	APPROACH SLAB DETAILS
71	PIILING DETAILS, CP
72	RAILING, TYPE P
73	RR 9
74	SWC - 61
75-76	BW - 61-(1) & (2)
77	CIS - 61
78	TRANSITION MARKER LAYOUT & SPECIAL SIGN DETAILS
79	M-61

FEDERAL AID PROJECT.  
U 312(5) & C 28-7-24  
PLAN: 1 IN. = 50 FT.  
PROFILE: 1 IN. HOR. = 50 FT., 1 IN. VERT. = 5 FT.  
CROSS-SECTIONS: 1 IN. HOR. AND VERT. = 1 FT.  
OTHERS AS NOTED.  
NET LENGTH OF PROJECT = 10,531.21 FT. = 3.097 MI.  
JEFFERSON COUNTY  
U.S. HIGHWAY 90  
FROM I.H. 10 TO WESCALDER ROAD  
GRADING, STRUCTURES AND CONCRETE PAVEMENT

Final Plans

CONT. 28-6-24 - RDWY. - 2500.44 FT. - 0.473 MILES  
CONT. 28-7-24 - RDWY. - 40.00 FT. - 0.007 MILES  
BRIDGES - 8000 FT. - 0.015 MILES  
CONT. 28-7-25 - RDWY. - 16,700.77 FT. - 3.163 MILES  
BRIDGES - 210.00 FT. - 0.039 MILES

TOTAL PROJECT: U 312(5) CONT. 28-6-24  
CONT. 28-7-25  
RDWY. - 19,201.21 FT. = 3.636 MILES  
BRIDGES - 210.00 FT. = 0.039 MILES  
19,411.21 FT. = 3.675 MILES  
TOTAL PROJECT: C 28-7-24  
RDWY. - 40.00 FT. = 0.007 MILES  
BRIDGES - 80.00 FT. = 0.015 MILES  
120.00 FT. = 0.022 MILES

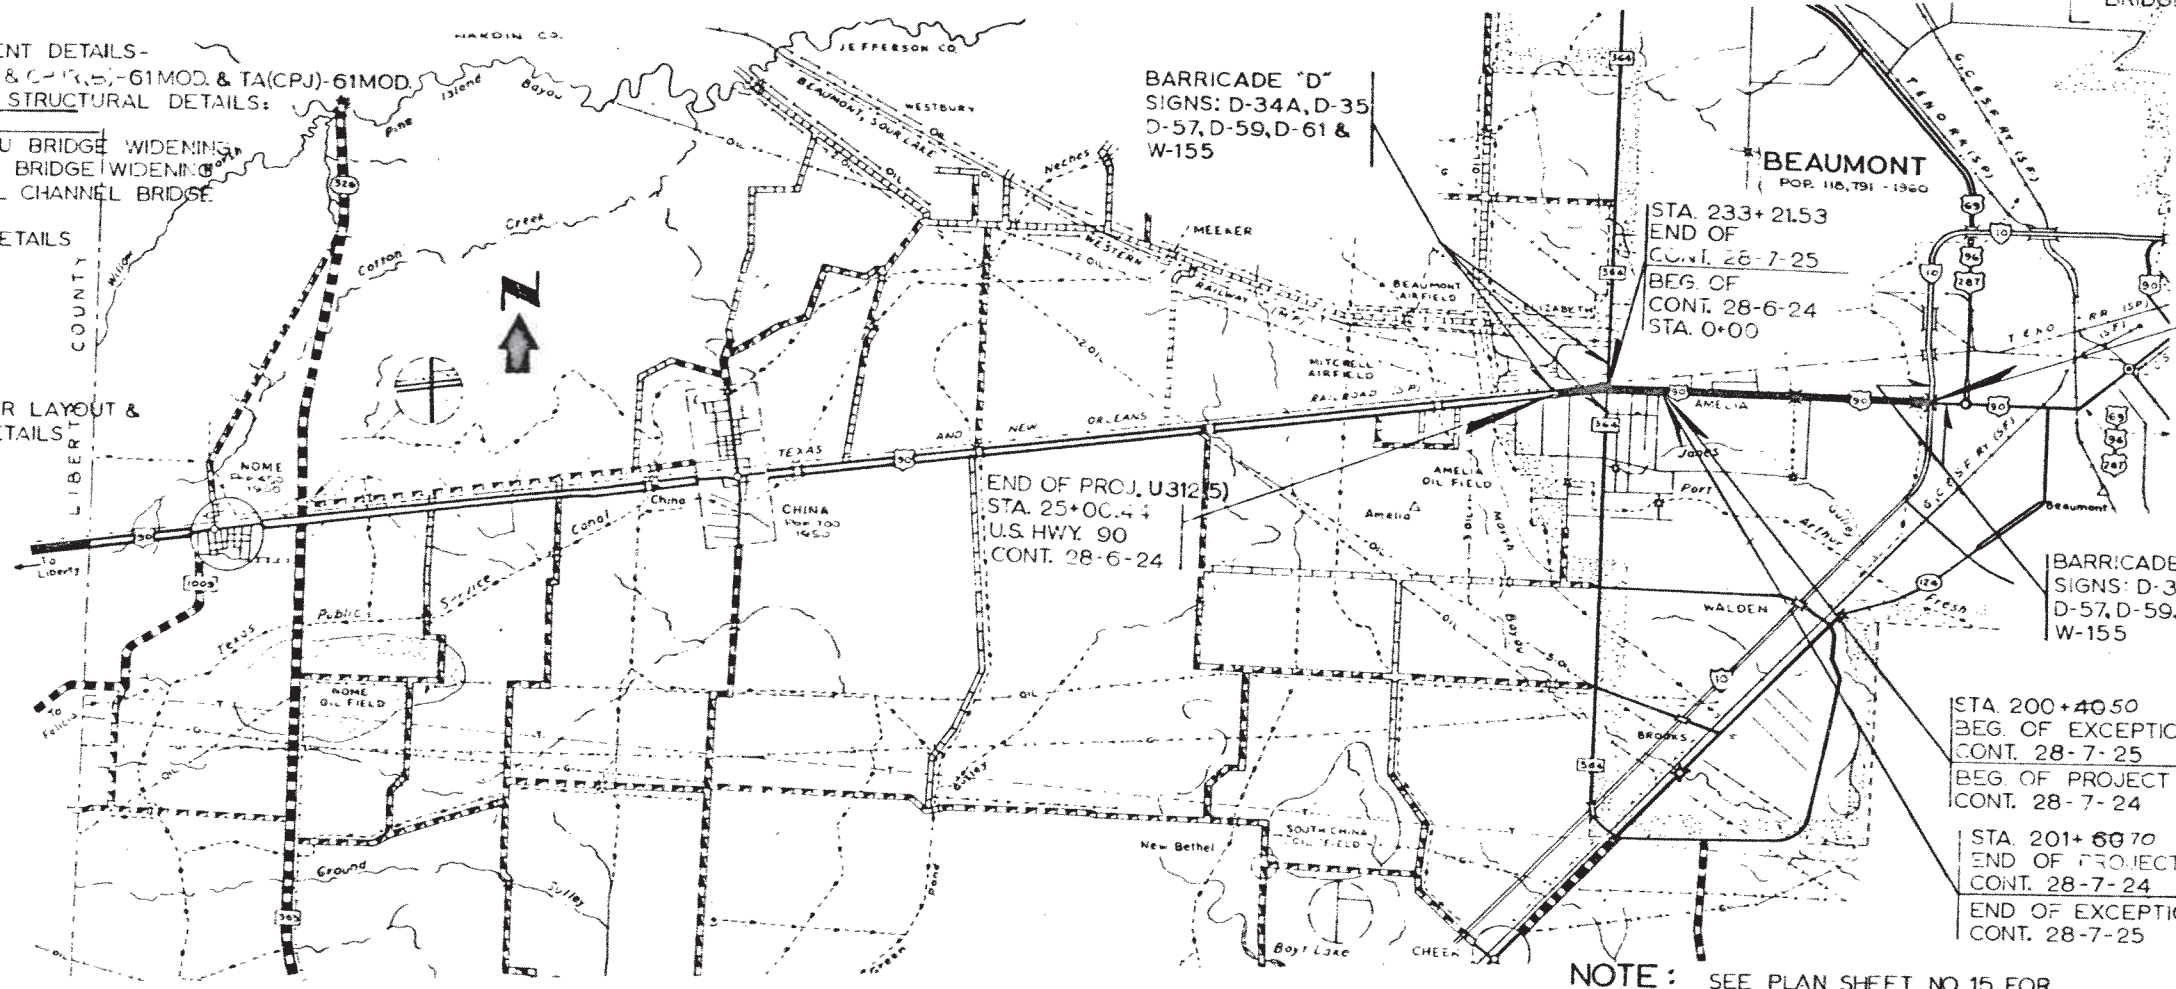

BEG. OF PROJECT U 312(5)  
STA. 63+22  
U.S. HWY. 90  
CONT. 25-7-25  
EQUALS STA. 11+00  
(COLLEGE ST. STA.)  
PROJ. I10-8(1) 859

EXCEPTIONS TO PROJ.  
Station 210+40 to Sta. 210+40  
EQUATION: Control 28-7-2  
Station 130+28.24 Backwa  
Equals  
Station 129+97.00 Forward  
PROJECT U 312(5)  
Station 233+21.53 Backwa  
Equals  
Station 0+00 Forward

STA. 200+40.50  
BEG. OF EXCEPTION  
CONT. 28-7-25  
BEG. OF PROJECT C 28-7-24  
CONT. 28-7-24  
STA. 201+60.70  
END OF PROJECT C 28-7-24  
CONT. 28-7-24  
END OF EXCEPTION  
CONT. 28-7-25

APPROVED:  
COUNTY ENGINEER, JEFFERSON COUNTY

NOTE: SEE PLAN SHEET NO 15 FOR  
FIELD CHANGES & WORK ORDERS.  
PROJECT CONSTRUCTED AND FINAL PLANS PREPARED BY  
MAY 29, 1964

STATE HIGHWAY DEPARTMENT  
JULY 25 1962


APPROVED  
SUPERVISOR








OCT. 8 1962

DEPARTMENT OF COMMERCE  
BUREAU OF PUBLIC ROADS


Specifications adopted by the State Highway Department of Texas  
January 2, 1962 and specification items listed and dated as follows  
shall govern on this project;  
Required Contract Provisions for Federal Aid Projects Approved  
Sept. 6, 1962.

NOTE: The contractor shall provide and erect  
Barricade and Warning Signs in accordance with  
BW-61-(1) & (2) and CIS-61 at points as shown  
on title sheet, layout sheet and as directed by  
the engineer.

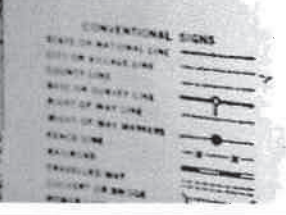


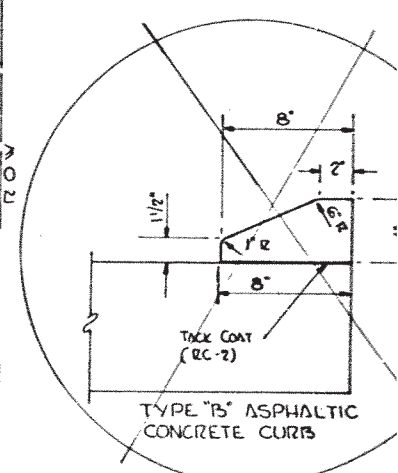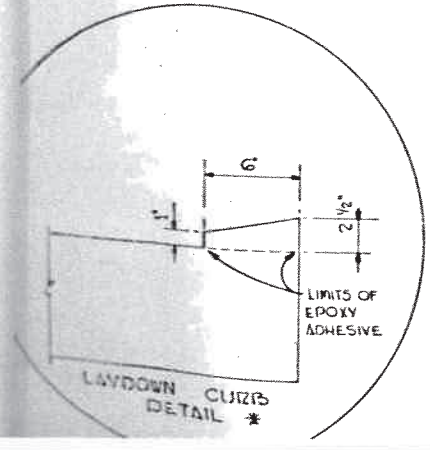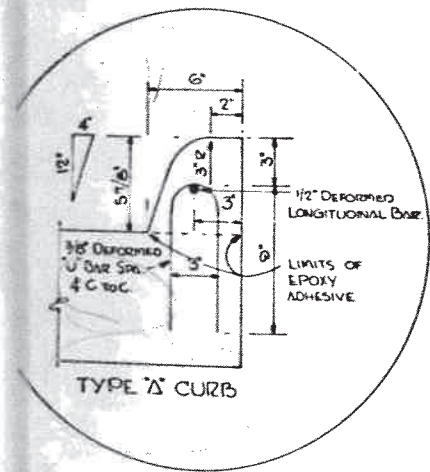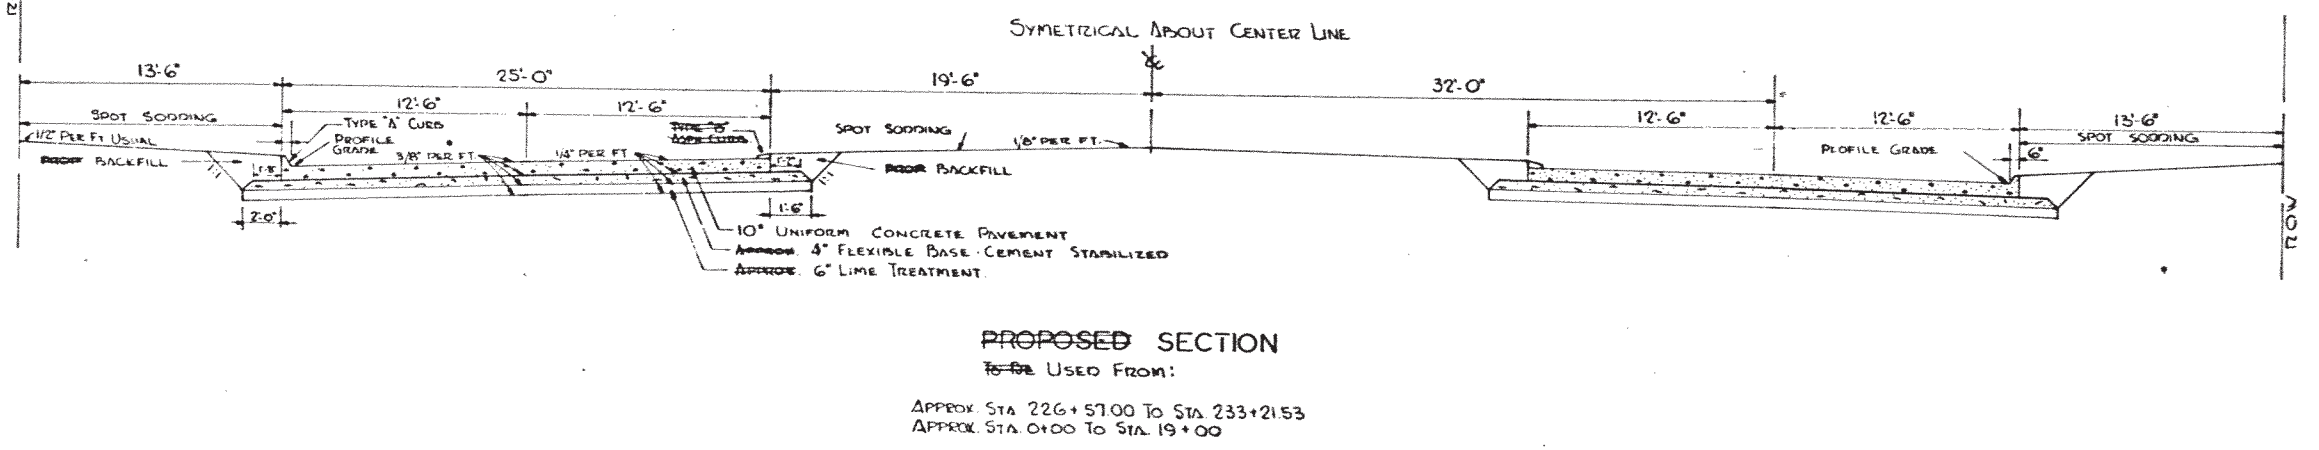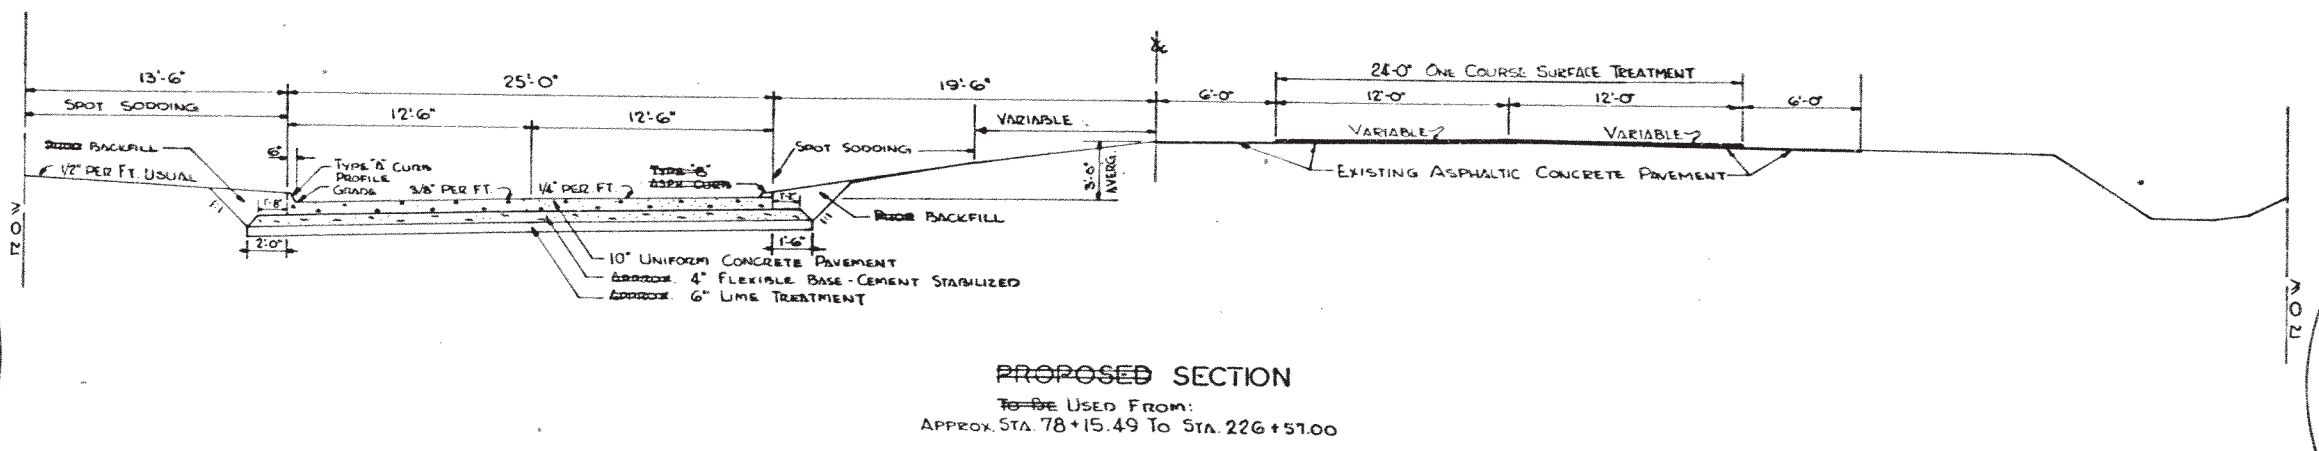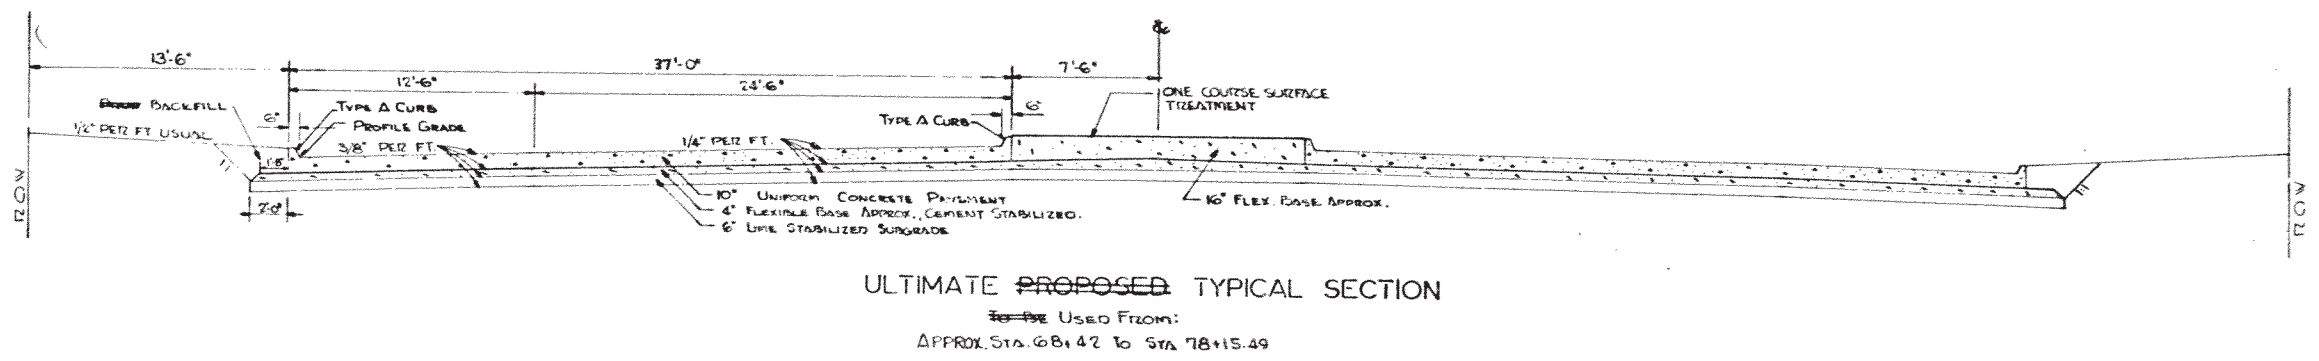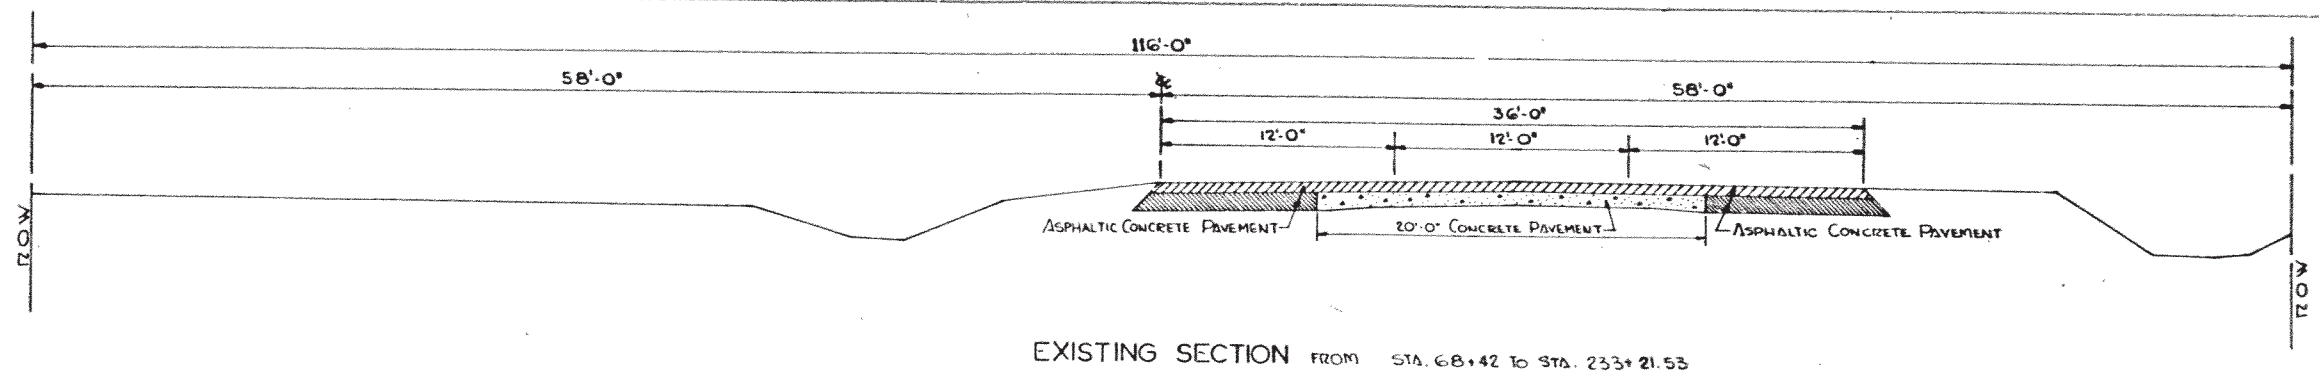




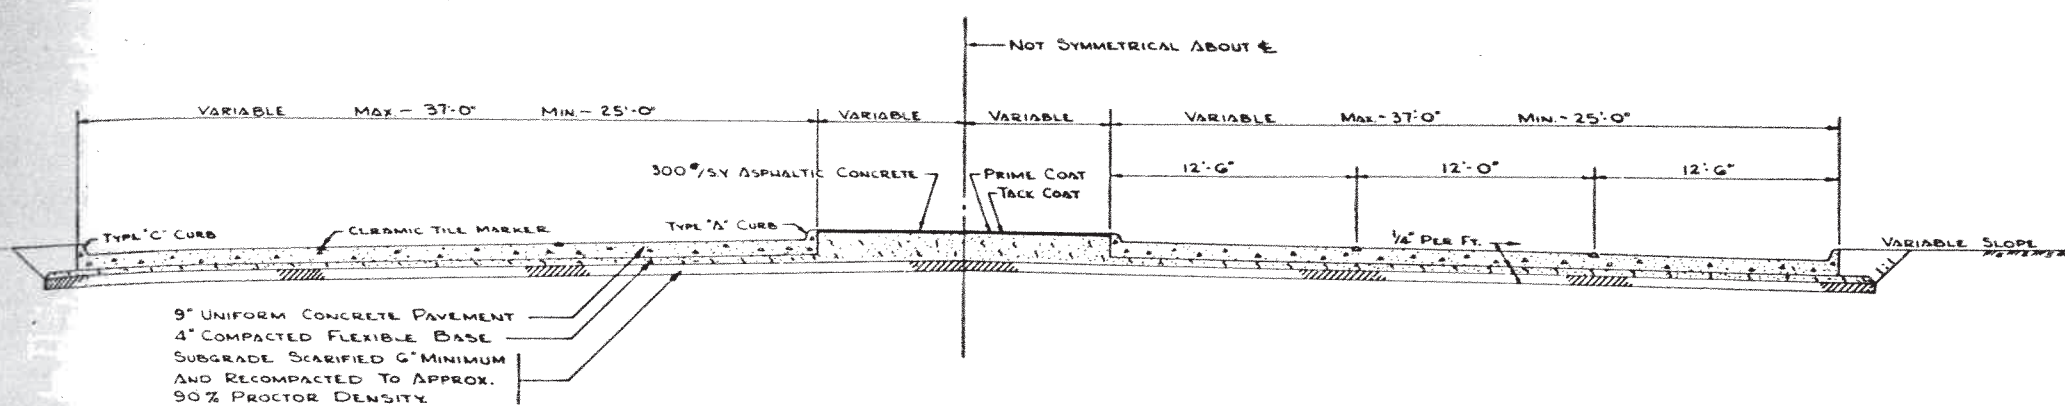


**EXISTING SECTION**  
STATION G3+00.00 TO STATION G7+02.00

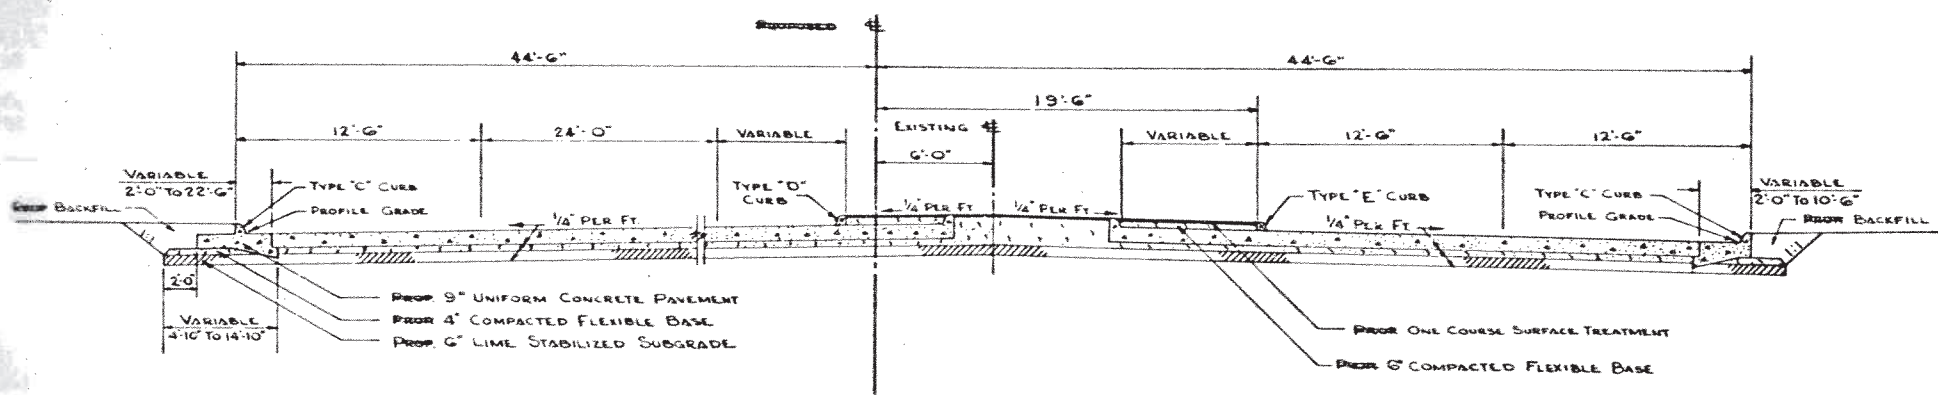



**PROPOSED WIDENED SECTION**  
APPROX. STATION G3+22.00 TO STATION G7+02.00  
APPROX. STATION G6+42.00 TO STATION G7+02.00 (HOT MIX ASPHALTIC CONCRETE OVERLAY - 162# SY AVERAGE)  
APPROX. STATION G7+02.20 TO STATION G8+42.00 (MEDIAN & BLOCKOUT ONLY)

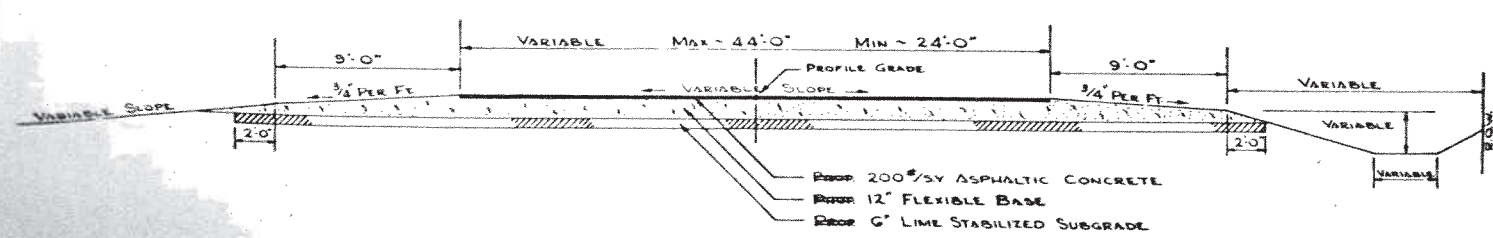


**TEMPORARY CONNECTION**  
APPROX. STATION 78+15.49 TO STATION 81+50  
APPROX. STATION 198+50 TO STATION 200+40  
APPROX. STATION 201+60 TO STATION 203+50

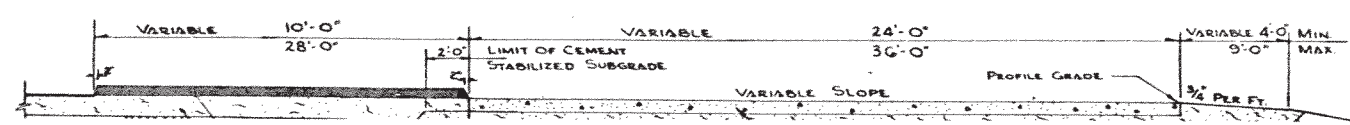


**TYPICAL SECTION**  
U.S. HWY. 90

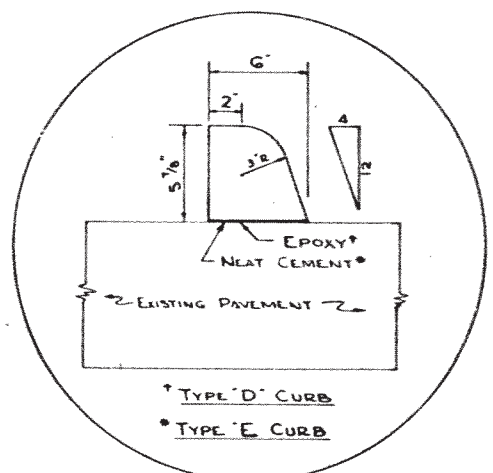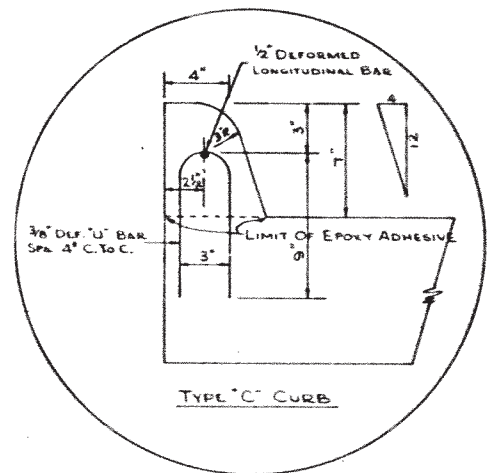


NOTE: THE CONTRACTOR MAY USE AN EXTRUSION MACHINE ON TYPES 'D' AND 'E' CURB AT HIS OPTION.

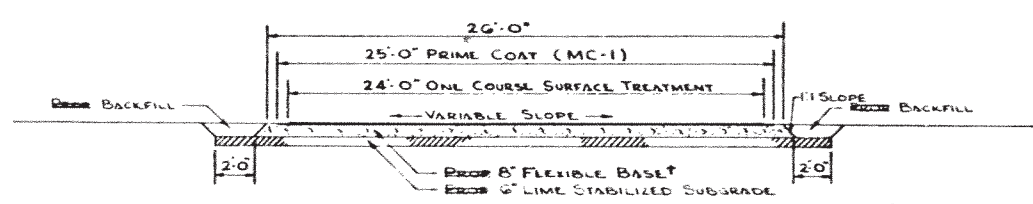


**DETOUR**  
APPROX. STATION G4+50 TO STATION G6+40  
APPROX. STATION 80+00 TO STATION 85+00  
APPROX. STATION 196+95 TO STATION 199+65  
APPROX. STATION 202+35 TO STATION 205+05  
APPROX. STATION 219+25 TO STATION 224+45  
ONE COURSE SURFACE TREATMENT ONLY.  
† TO BE SALVAGED AND REPLACED ON SHOULDERS STATION 19+00 TO STATION 25+00.44.

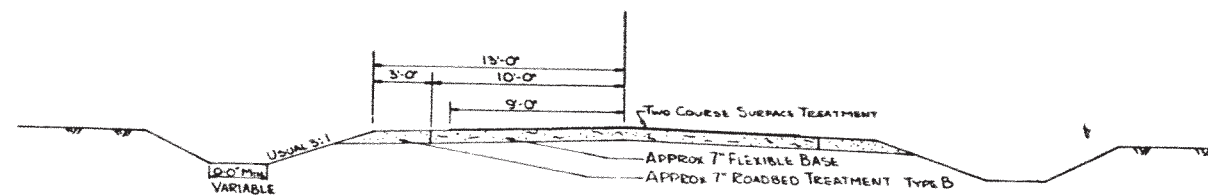


EXISTING SECTION  
STA 0+00 TO STA 5+16.05 S

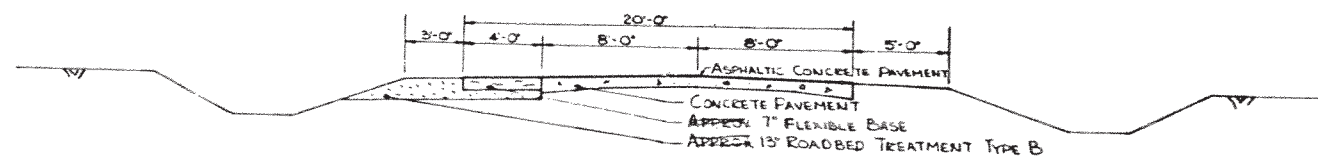


EXISTING SECTION  
STA 0+00 TO STA 5+00.09 N

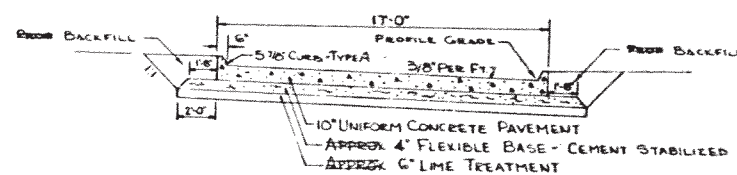



PROPOSED SECTION  
RIGHT TURN LANES

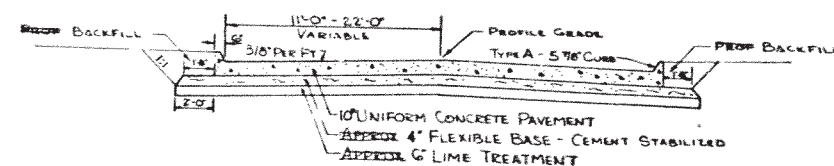




PROPOSED SECTION  
APPROX STA 0+44 TO STA 1+65 N  
APPROX STA 0+44 TO STA 2+00 S

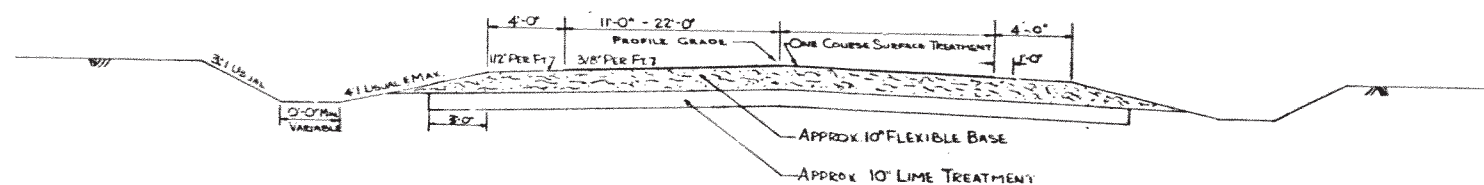

PROPOSED SECTION  
APPROX STA 1+65 TO STA 5+00.09 N  
APPROX STA 2+00 TO STA 5+16.05 S

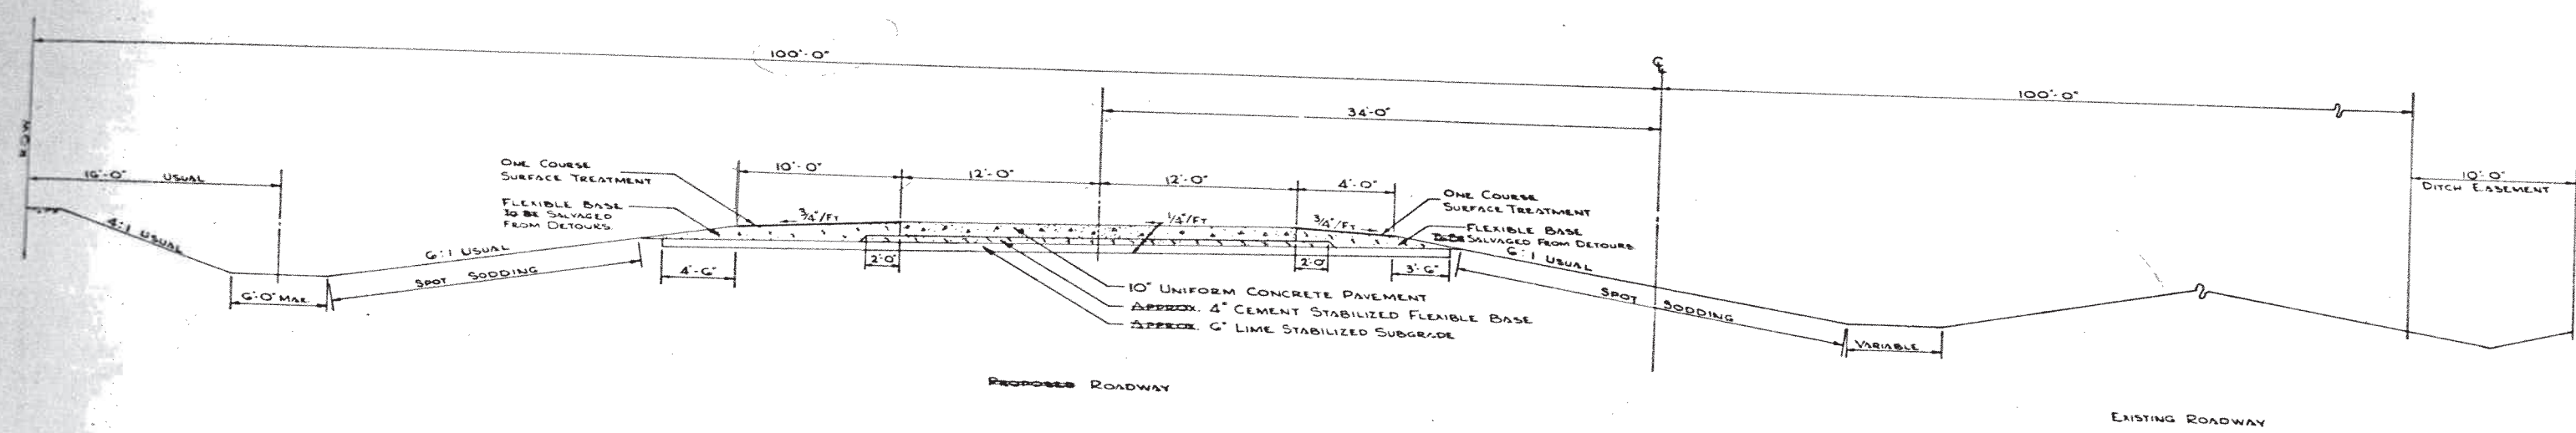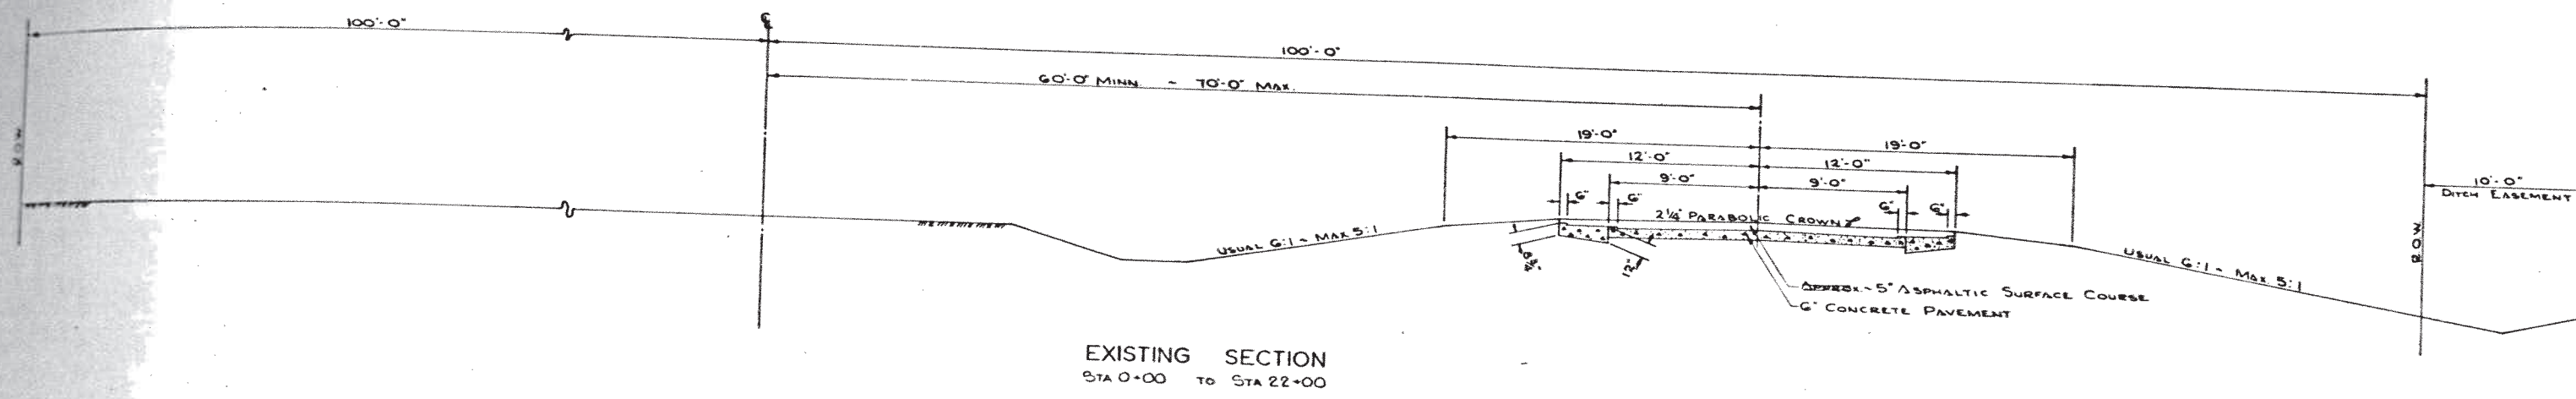


TO BE USED FROM:  
 APPROX. STATION 19+00 TO STATION 25+00.44 LEFT LANE  
 APPROX. STATION 19+43

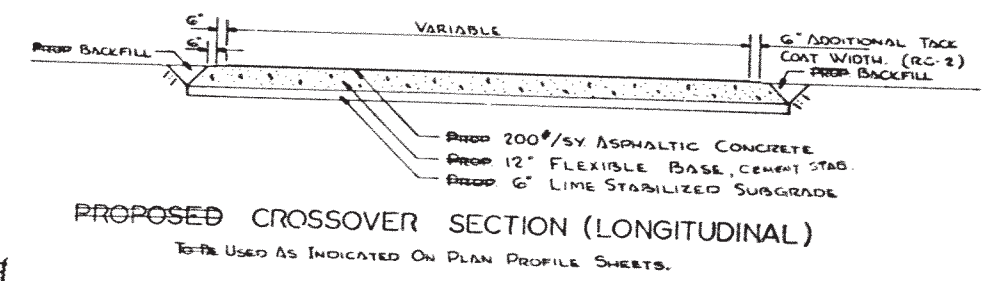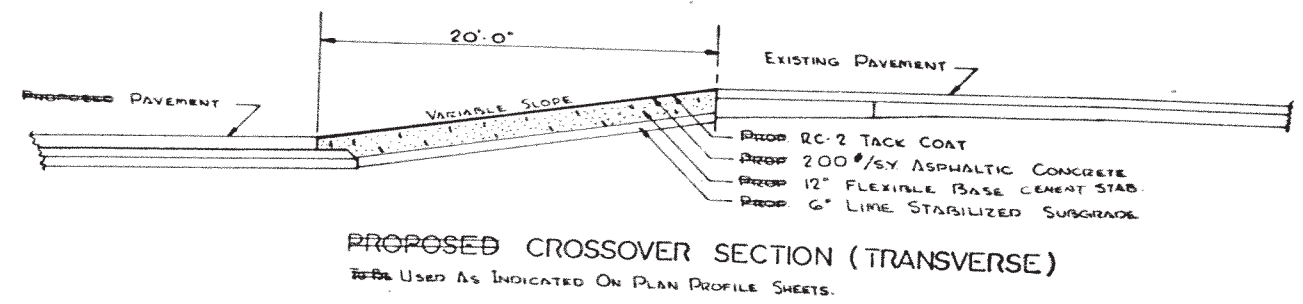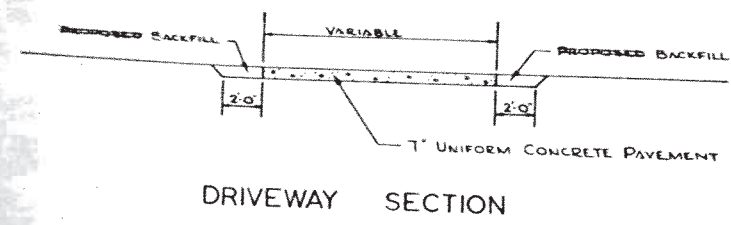


45 HWY 90  
 TYPICAL SECTION




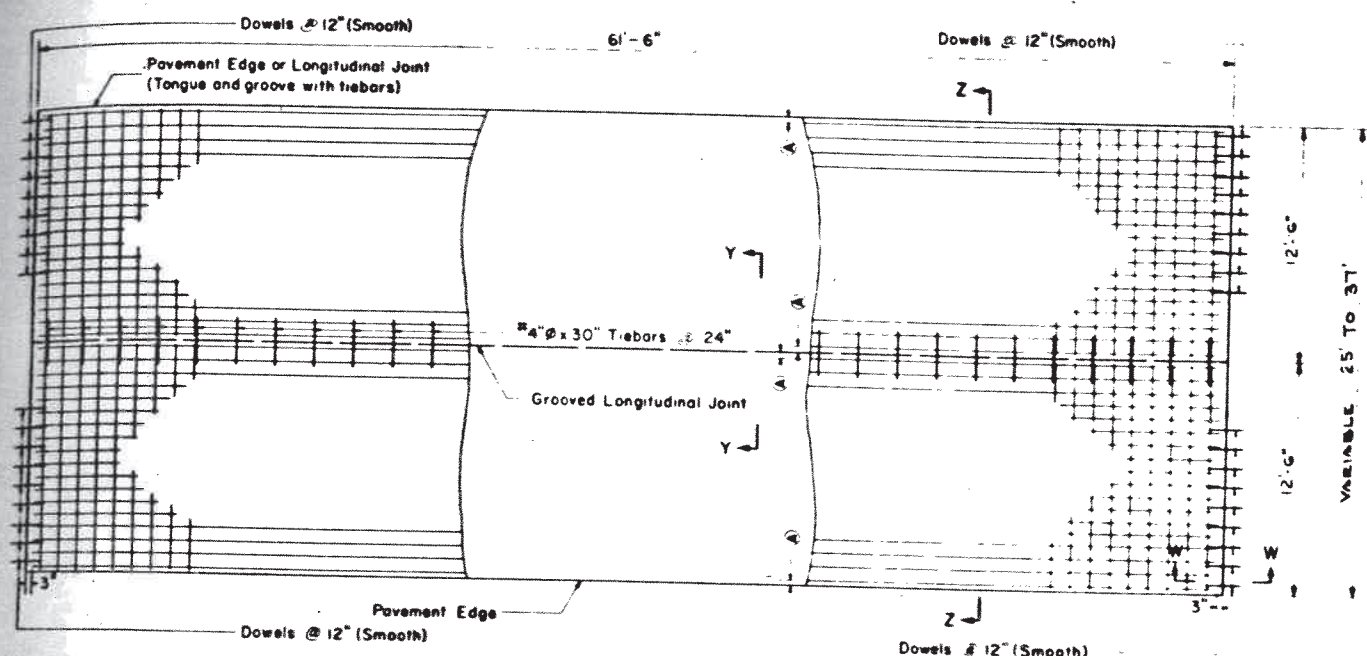


PAVEMENT PLAN

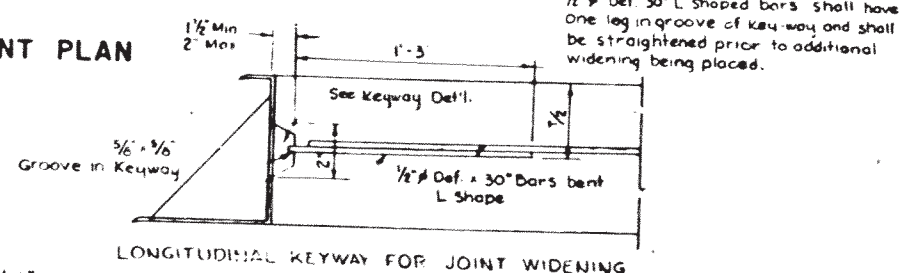

LONGITUDINAL KEYWAY FOR JOINT WIDENING

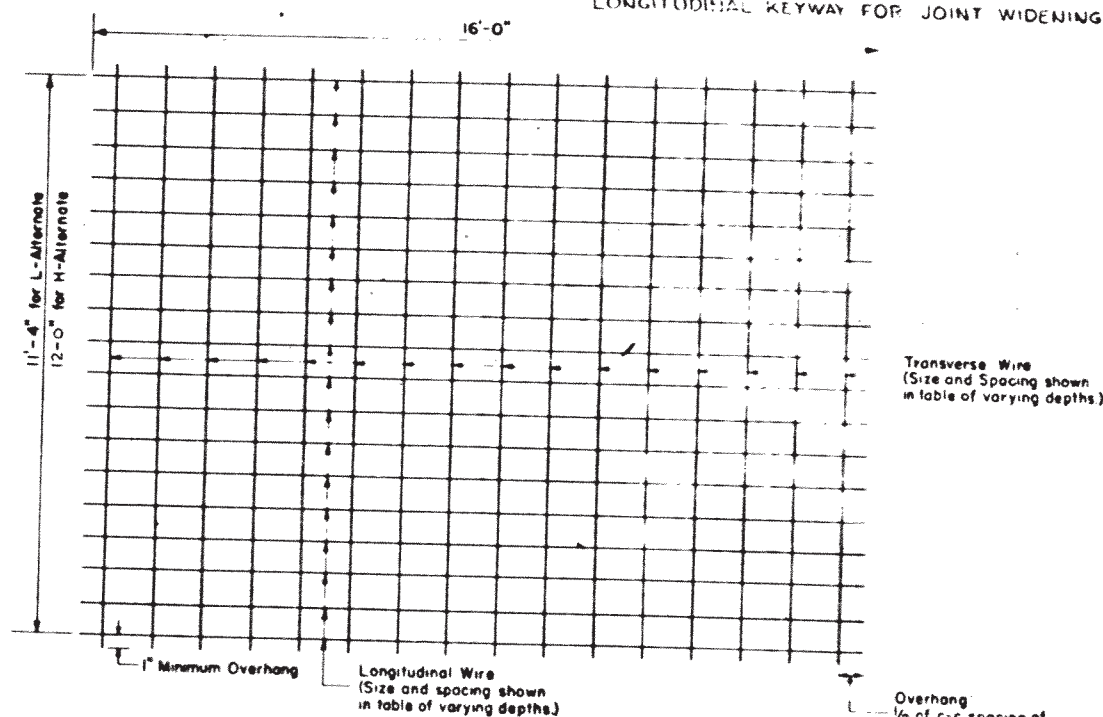


TYPICAL SHEET OF WELDED WIRE FABRIC

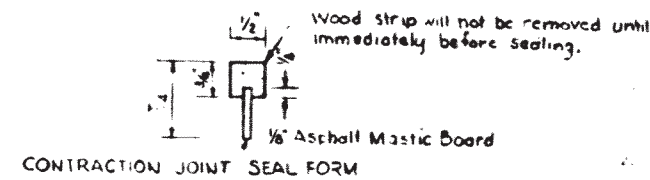


GENERAL NOTES

- ALL GROOVED JOINTS SHALL BE SAWED VERTICAL AND TRUE TO LINE BY AN APPROVED METHOD AND FILLED WITH JOINT SEALING COMPOUND.
- CONSTRUCTION JOINTS MAY BE FORMED BY THE USE OF METAL OR WOOD FORMS EQUAL IN DEPTH TO THE NOMINAL DEPTH OF THE PAVEMENT, OR BY OTHER MEANS WHICH HAVE BEEN APPROVED BY THE ENGINEER PRIOR TO THEIR USE.
- TREATMENT OF PAVEMENT ENDS AT STRUCTURES OR AT FIXED OBJECTS WILL BE SHOWN ELSEWHERE IN THE PLANS.
- FOR FURTHER INFORMATION REGARDING THE PLACEMENT OF CONCRETE AND REINFORCEMENT REFER TO THE GOVERNING SPECIFICATIONS FOR CONCRETE PAVEMENT.
- DETAILS AS TO PAVEMENT WIDTH, PAVEMENT THICKNESS, AND THE CROWN CROS-SLOPE SHALL BE AS SHOWN ELSEWHERE IN THE PLANS.
- THE MINIMUM TRANSVERSE LAP OF THE WELDED WIRE FABRIC SHALL BE 12 INCHES LONG. THE MINIMUM LONGITUDINAL LAP, IF USED, SHALL BE EQUAL TO THE CENTER TO CENTER SPACING OF THE LONGITUDINAL WIRE.
- WITH THE INTENT OF THIS DESIGN THAT THE LONGITUDINAL STEEL BE AT THE CENTER OF THE SLAB. IT SHALL BE THE RESPONSIBILITY OF THE CONTRACTOR TO TAKE ALL NECESSARY PRECAUTIONS TO INSURE THAT THE FINAL POSITION OF THE STEEL IS WITHIN 1/2 INCH OF THE SLAB CENTER.
- CONCRETE SHALL NOT BE DISCHARGED FROM THE MIXER DIRECTLY ON TOP OF OR ON THE SIDES OF THE JOINT ASSEMBLY.
- THE CONTRACTOR SHALL HOLD AND SAVE THE STATE, ITS OFFICERS, ITS AGENTS, AND ITS EMPLOYEES HARMLESS TO LIABILITY OF ANY NATURE OR KIND, INCLUDING COST AND EXPENSES FOR OR ON ACCOUNT OF ANY PATENT OR UNPATENTED INVENTION, ARTICLE OR APPLIANCE MANUFACTURED OR USED IN ACCORDANCE WITH THE DETAILS OF THESE PLANS.
- FABRIC MAY BE PLACED EITHER TOP OR BOTTOM OF JOINT STEEL.


CONTRACTION JOINT  
Section W-W

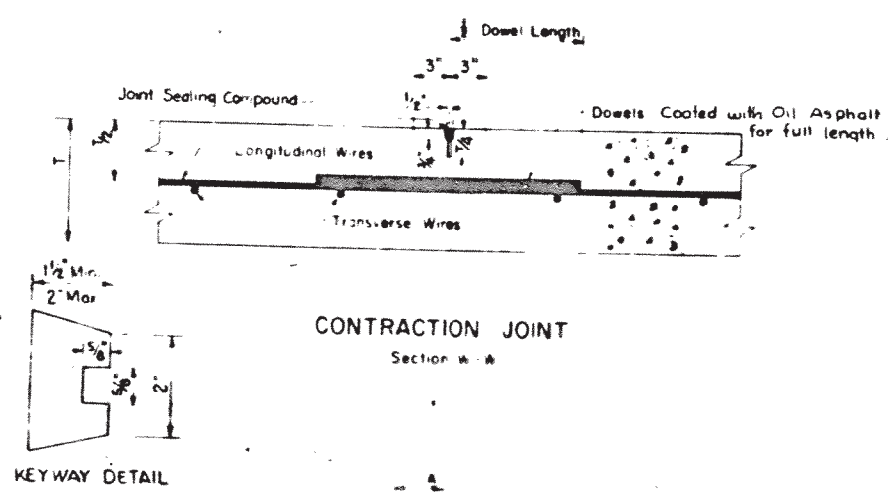

LONGITUDINAL CONSTRUCTION JOINT  
(Tongue and Groove with T.Ebars)

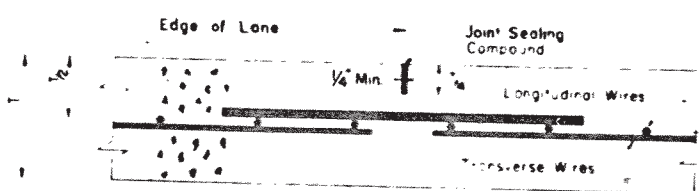

GROOVED LONGITUDINAL JOINT  
(Sawed)  
Section Y-Y

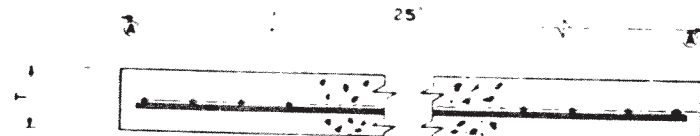

TYPICAL SECTION  
Section Z-Z

TABLE OF VARYING DEPTHS									
Alternate Designs	(T) Pavement Thickness (inches)	Steel Welded Wire Fabric Style No.	Edge Spacing (A)	Weight (lb/sy)	Dowels (Smooth Bars) Size	Average Spacing (in.)	Weight (lb/sy)	Tiebars (Deformed Bars) Size	Average Spacing (in.)
L	10	812-1/2-1	4	5.58	11x22	12	7.89	4x30	24
	9	812-1/2-1	4	5.58	10x20	12	5.66	4x30	24
	8	812-12	4	4.71	8x18	12	4.01	4x30	30
H	10	68-1/2-1	3	7.66	11x22	12	7.89	4x30	18
	9	68-1/2-1	3	7.66	10x20	12	5.66	4x30	20
	8	68-13	3	6.20	8x18	12	4.01	4x30	22


- One of the alternate designs must be crossed out.
  - Alternate - to be used with subbase having a low friction factor
  - Alternate - to be used with subbase having a high friction factor
- Steel weights are for contractors information only.
  - \*Code for welded wire fabric
- 8 Gauge of transverse wire
  - 12 Gauge of longitudinal wire
  - 6 Spacing of transverse wire (in)
  - 1 Spacing of longitudinal wire (in)
- ALL DOWEL BARS TO BE FASTENED IN THEIR PROPER POSITION USE OF A DOWEL CHAIR OF A TYPE APPROVED BY THE ENGINEER.

(GENERAL NOTES CONT'D.)


- JOINT SEALING COMPOUND SHALL CONFORM TO THE REQUIREMENTS FOR CLASS I-a AND CLASS I-b JOINT SEALER.
- KEYWAYS SHALL BE PROVIDED ON INSIDE EDGE OF PAVEMENT TO ALLOW FOR FUTURE WIDENING, AS DIRECTED BY THE ENGINEER.

TEXAS HIGHWAY DEPARTMENT  
CONCRETE PAVEMENT DETAILS  
JOINTED REINFORCED  
WELDED WIRE FABRIC




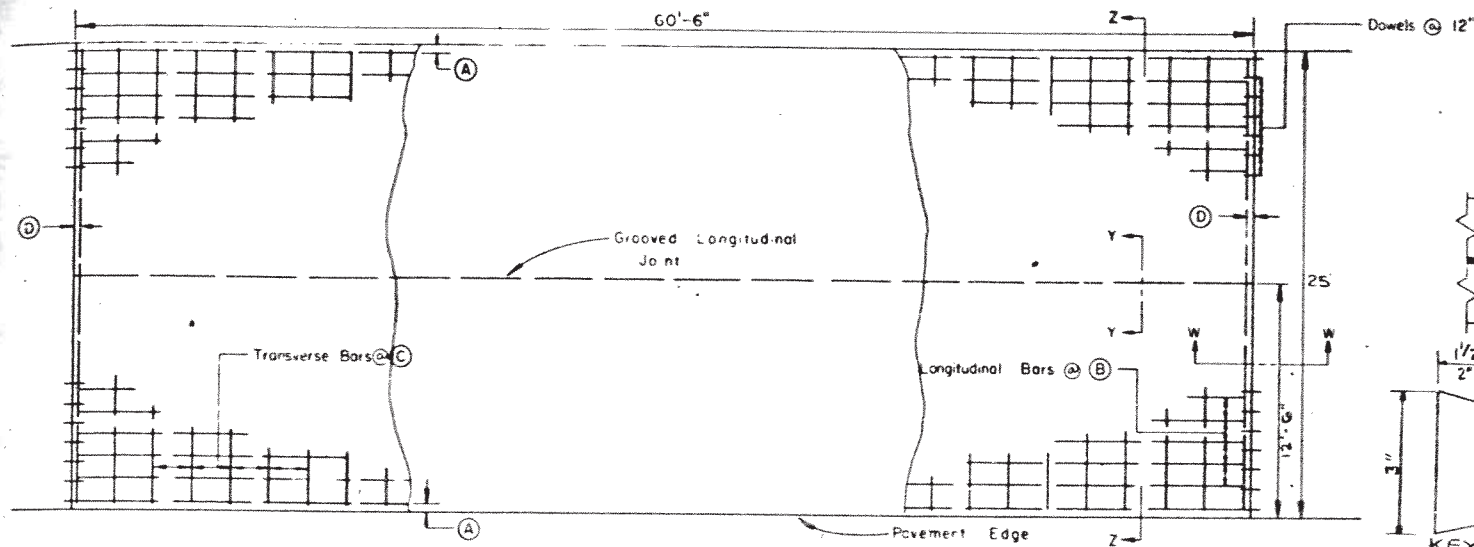


TWO LANE PAVEMENT PLAN  
(25 ft Placement)\*

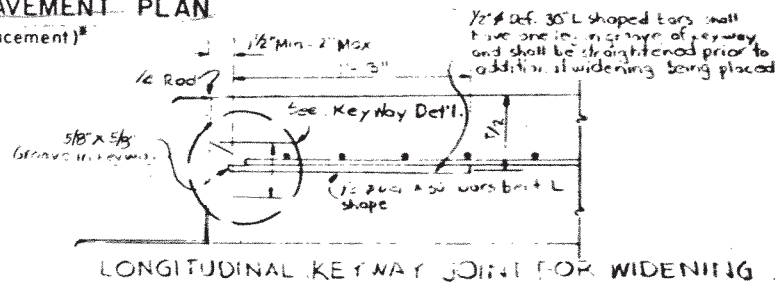

LONGITUDINAL KEYWAY JOINT FOR WIDENING

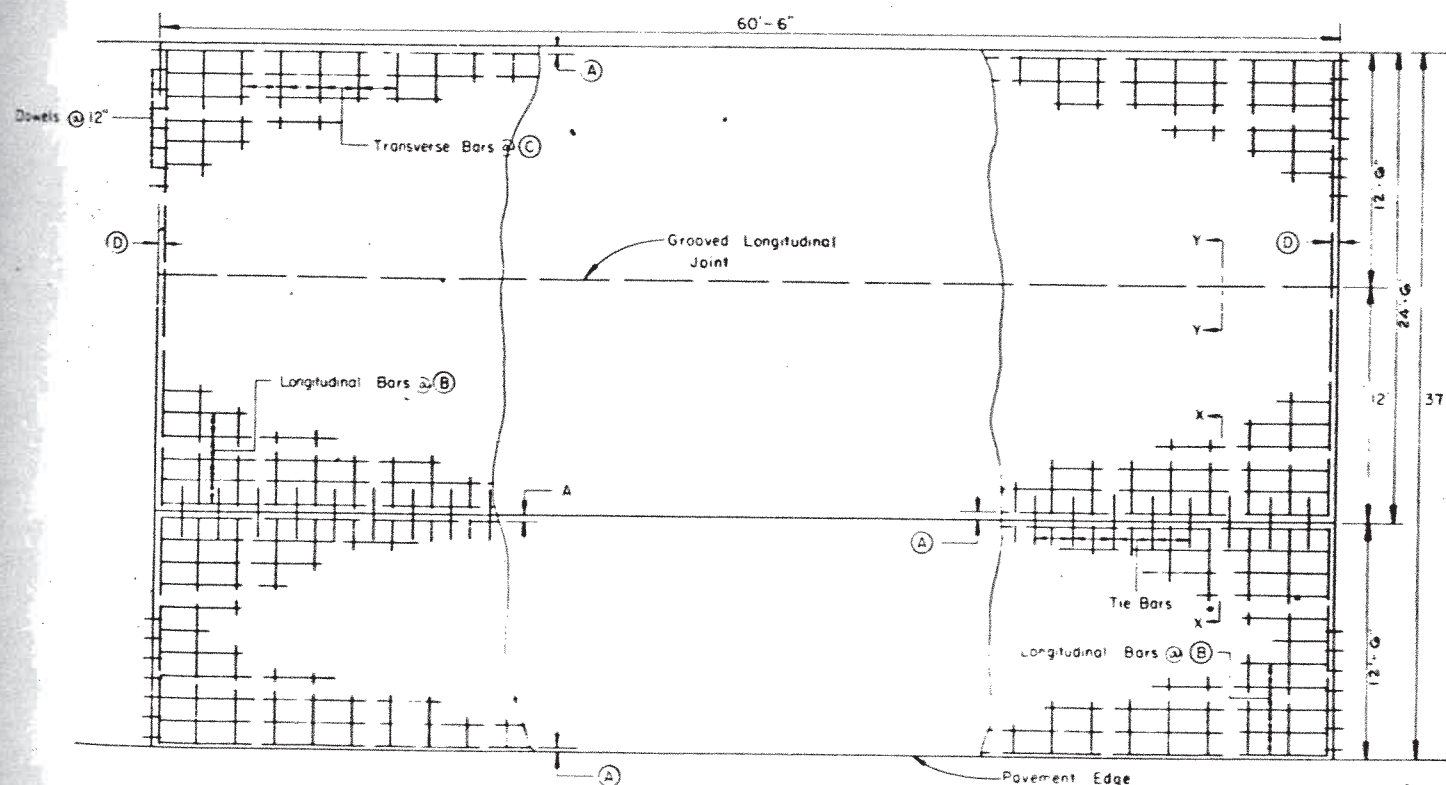

THREE LANE PAVEMENT PLAN  
(2 1/2 ft and 24 1/2 ft Placement)\*

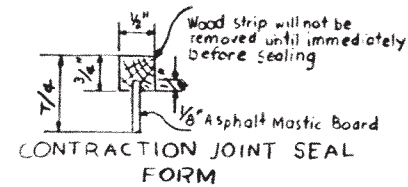

# GENERAL NOTES


- ALL GROOVED JOINTS SHALL BE ~~FORMED~~ SAWED VERTICAL AND TRUE TO LINE BY AN APPROVE METHOD AND FILLED WITH JOINT SEALING COMPOUND.
- CONSTRUCTION JOINTS MAY BE FORMED BY THE USE OF METAL OR WOOD FORMS EQUAL IN DEPT TO THE NOMINAL DEPTH OF THE PAVEMENT, OR BY OTHER MEANS WHICH HAVE BEEN APPROVED BY THE ENGINEER PRIOR TO THEIR USE.
- TREATMENT OF PAVEMENT ENDS AT STRUCTURES OR AT FIXED OBJECTS WILL BE SHOWN ELSEWHERE IN THE PLANS.
- FOR FURTHER INFORMATION REGARDING THE PLACEMENT OF CONCRETE AND REINFORCEMENT RE TO THE GOVERNING SPECIFICATIONS FOR "CONCRETE PAVEMENT".
- DETAILS AS TO PAVEMENT WIDTH, PAVEMENT THICKNESS, AND THE CROWN CROSS-SLOPE SHALL AS SHOWN ELSEWHERE IN THE PLANS.
- LONGITUDINAL BARS AND TRANSVERSE BARS SHALL BE INTERMEDIATE GRADE, HARD GRADE, OR HI YIELD STEEL IN ACCORDANCE WITH THE SIZE AND SPACING SHOWN IN THE TABLE, EXCEPT THAT ONLY INTERMEDIATE GRADE STEEL SHALL BE USED WHERE BARS ARE TO BE BENT.
- IT IS THE INTENT OF THIS DESIGN THAT THE LONGITUDINAL STEEL BE AT THE CENTER OF THE SLAB. SHALL BE THE RESPONSIBILITY OF THE CONTRACTOR TO TAKE ALL NECESSARY PRECAUTIONS TO IN THAT THE FINAL POSITION OF THE STEEL IS WITHIN 1/2 INCH OF THE SLAB CENTER.
- CONCRETE SHALL NOT BE DISCHARGED FROM THE MIXER DIRECTLY ON TOP OF OR ON THE SIDES C JOINT ASSEMBLY.
- ANY APPROVED METAL CHAIR TYPE OR DESIGN, WHICH WILL SATISFY THE REQUIREMENTS NOTED H WILL BE PERMITTED. CHAIR SPACINGS SHALL NOT BE GREATER THAN 50" C-C MEASURED PARALLEL PAVEMENT CENTER LINE AND 33" C-C MEASURED PERPENDICULAR TO THE PAVEMENT CENTER LINE. ADDITIONAL CHAIRS SHALL BE USED IF NECESSARY TO MEET THE STEEL PLACEMENT REQUIREMENTS.
- THE CONTRACTOR SHALL HOLD AND SAVE THE STATE, ITS OFFICERS, ITS AGENTS, AND ITS EMPLOY HARMLESS TO LIABILITY OF ANY NATURE OR KIND, INCLUDING COST AND EXPENSES FOR OR ON OF ANY PATENT OR UNPATENTED INVENTION, ARTICLE OR APPLIANCE MANUFACTURED OR USED I ACCORDANCE WITH THE DETAILS OF THESE PLANS.

TABLE OF REINFORCING STEEL SIZES, SPACINGS AND ESTIMATED QUANTITIES


ALTERNATE DESIGNS 1)	PAVEMENT THICKNESS 2) (INCHES)	24' PLACEMENT WIDTH							12' PLACEMENT WIDTH							DOWELS (SMOOTH BARS)				TIE (ID)			
		LONGITUDINAL			TRANSVERSE				2) STEEL #/SY	LONGITUDINAL			TRANSVERSE				2) STEEL #/SY	SIZE			AVG WT (LB)	WT #/FT OF JO	SIZE
		BAR #	SPAC (A) (IN)	SPAC (B) (IN)	BAR #	SPAC (A) (IN)	SPAC (B) (IN)	BAR #		SPAC (A) (IN)	SPAC (B) (IN)	BAR #	SPAC (A) (IN)	SPAC (B) (IN)	SIZE (IN)	SPAC (IN)							
L	10	3	4	8	4	24	3	805	3	4	8	4	24	3	7.71	#11 X22	12	7.89	#4 X30				
	9	3	4	8 1/2	4	26 1/2	5 1/4	748	3	4	8 1/2	4	26 1/2	5 1/4	7.14	#10 X20	12	5.68	#4 X30				
	8	3	4	10	4	30	3	648	3	2	10	4	30	3	6.30	#8 X18	12	4.01	#4 X30				
H	10	4	4 1/2	10 1/2	4	18	3	1070	4	7 1/2	10 1/2	4	18	3	10.84	#11 X22	12	5.74	#4 X30				
	9	4	6	12	4	20	3	957	4	6	12	4	20	3	9.48	#10 X20	12	7.17	#4 X30				
	8	4	2 1/2	13 1/2	4	22	11	868	4	4 1/2	13 1/2	4	22	11	8.60	#8 X18	12	4.01	#4 X30				

## NOTE:


- One of the alternate designs must be crossed out.
    - alternate - to be used with subbases having a low friction factor.
    - alternate - to be used with subbases having a high friction factor.
  - Steel weights are for contractor's use only and include weights of longitudinal and transverse bars.
- (GENERAL NOTES CONT.)
- JOINT SEALING COMPOUND SHALL CONFORM TO THE REQUIREMENTS FOR CLASS 1-A AND CLASS 1-B JO
  - KEYWAYS SHALL BE PROVIDED ON INSIDE EDGE OF PAVEMENT TO ALLOW FOR FUTURE WIDENING

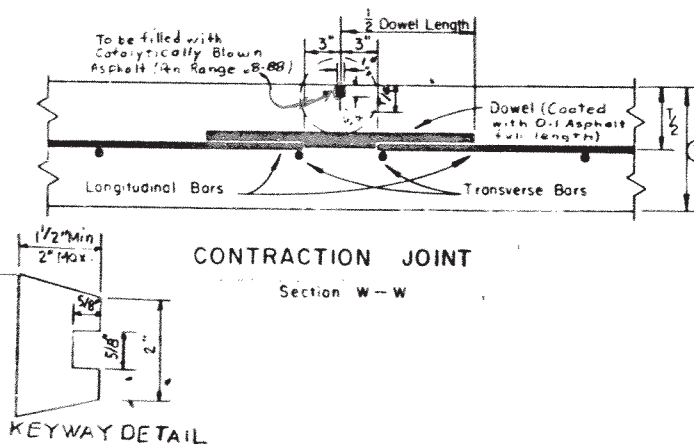


CONTRACTION JOINT  
Section W-W

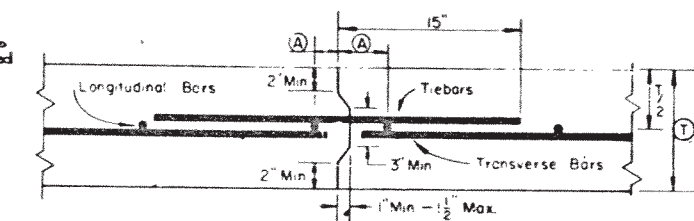

LONGITUDINAL CONSTRUCTION JOINT  
(Tongue and Groove with Tie Bars)  
Section X-X

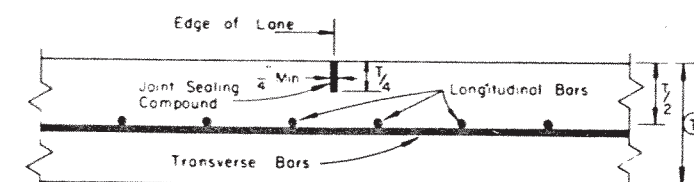


GROOVED LONGITUDINAL JOINT  
(Sawed or Formed with Tie Bars)  
Section Y-Y

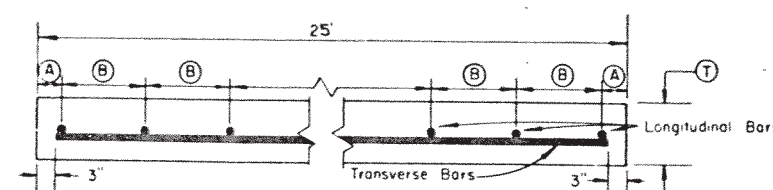


TYPICAL SECTION  
Section Z-Z

## TEXAS HIGHWAY DEPARTMENT CONCRETE PAVEMENT DETAILS JOINTED REINFORCED STEEL BARS



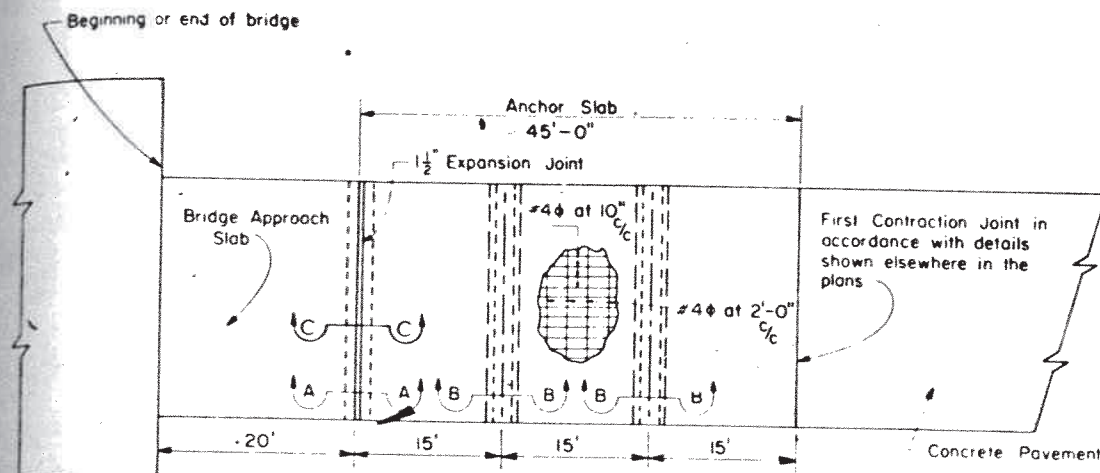

PLAN VIEW

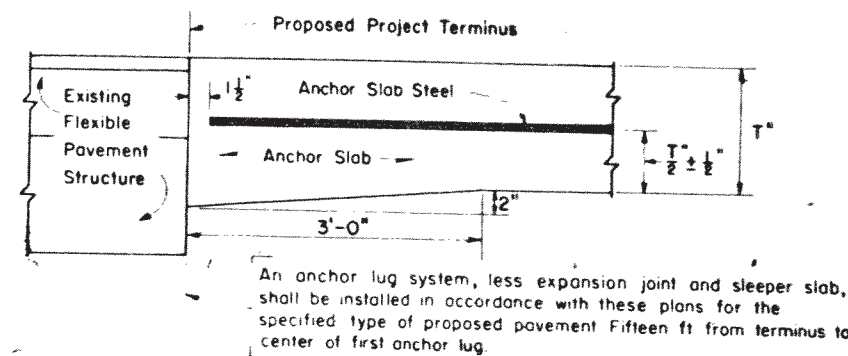


PAVEMENT TERMINUS DETAIL FOR JUNCTURE WITH EXISTING FLEXIBLE TYPE PAVEMENT STRUCTURE

NOTE: Details of juncture with existing concrete pavements (if applicable) shall be as shown elsewhere in the plans.


# GENERAL NOTES

1. THE REQUIREMENTS OF THE BRIDGE APPROACH SLAB DESIGN AND THICKNESS SHALL BE AS SHOWN ELSEWHERE IN THE PLANS.
2. FOR FURTHER INFORMATION REGARDING THE PLACEMENT OF CONCRETE AND REINFORCING STEEL REFER TO THE ITEM "TERMINAL ANCHORAGE (CONCRETE PAVEMENT)".
3. DETAILS AS TO ANCHOR SLAB WIDTH, THICKNESS, CROWN CROSS-SLOPE, AND LOCATION AND TYPE OF LONGITUDINAL JOINTS SHALL BE AS SHOWN ELSEWHERE ON THE PLANS.
4. ALL CONCRETE SHALL BE PLACED AND FINISHED IN ACCORDANCE WITH THE SLEEPER SLAB, LUG ANCHORS, AND ANCHOR SLAB SHALL BE MEASURED AND PAID FOR UNDER THE ITEM "TERMINAL ANCHORAGE (CONCRETE PAVEMENT)" EXCEPT THAT PAYMENT WILL NOT BE MADE FOR CONCRETE USED IN BACK FILLING OVER-EXCAVATED AREA OF LUG ANCHORS OR SLEEPER SLABS.
5. THE USE OF THIS DESIGN INVOLVES THE MODIFICATION OF THE BRIDGE APPROACH DETAIL AS SHOWN HEREON.
6. THE CONTRACTOR SHALL HOLD AND SAVE THE STATE, ITS OFFICERS, ITS AGENTS, EMPLOYEES HARMLESS TO LIABILITY OF ANY NATURE OR KIND, INCLUDING COSTS EXPENSES FOR OR ON ACCOUNT OF ANY PATENTED OR UNPATENTED INVENTION, ARTICLE OR APPLIANCE MANUFACTURED OR USED IN ACCORDANCE WITH THE DETAILS OF THESE PLANS.
7. THE LOCATIONS OF THE TERMINAL ANCHORAGE SYSTEM SHALL BE AS SHOWN ELSEWHERE IN THE PLANS.
8. REINFORCING STEEL BARS SHALL BE OF THE SIZE AND SPACING AS DETAILED HEREON. REINFORCING STEEL SHALL BE MEASURED AND PAID FOR UNDER THE ITEM "TERMINAL ANCHORAGE (CONCRETE PAVEMENT)" WITH THE PROVISION THAT THAT REQUIRE FIELD BENDING SHALL BE OF STRUCTURAL OR INTERMEDIATE GRADE.
9. TRANSVERSE CONSTRUCTION JOINTS IN THE ANCHOR SLAB WILL NOT BE ALLOWED. IN AN EMERGENCY STOPPAGE OF THE CONCRETE PLACEMENT AND WITH THE APPROVAL OF THE ENGINEER, AT TRANSVERSE CONSTRUCTION JOINTS THE REGULAR LONGITUDINAL BARS SHALL EXTEND BEYOND THE JOINT SUCH THAT THE BAR SPLICES FOR THE REGULAR LONGITUDINAL BARS SHALL BE A MINIMUM OF FOUR FEET FROM THE CONSTRUCTION JOINT.
10. AT LONGITUDINAL CONSTRUCTION JOINTS, IF THE CONTRACTOR ELECTS TO CONTINUE THE REGULAR TRANSVERSE STEEL THROUGH THE JOINT, THE #4 TIE BARS SHOWN MAY BE OMITTED.
11. ANY APPROVED METAL CHAIR TYPE OR DESIGN, WHICH WILL SATISFY THE REQUIREMENTS HEREON, WILL BE PERMITTED. CHAIR SPACINGS SHALL NOT BE GREATER THAN 4'-0" MEASURED PARALLEL TO THE PAVEMENT CENTER LINE AND 3'-0" C-C MEASURED PERPENDICULAR TO THE PAVEMENT CENTER LINE. ADDITIONAL CHAIRS SHALL BE USED IF NECESSARY TO MEET THE STEEL PLACEMENT REQUIREMENTS.
12. FOR STEEP BRIDGES, THE APPROACH SLAB AND EXPANSION JOINT WILL BE SKEWED PER BRIDGE. LONGITUDINAL DIMENSION OF APPROACH SLAB, ANCHOR SLAB, AND ANCHOR LUG SPACINGS SHALL BE MEASURED ALONG THE CENTER LINE OF PAVEMENT.
13. TRANSVERSE REINFORCING RODS TO BE EXTENDED 1'-3" BEYOND THE SURFACE OF THE LUG ANCHOR CONCRETE ON THE MEDIAN SIDE OF THE PAVEMENT TO A FOR FUTURE PAVING. THE REINFORCING STEEL SHALL BE PAINTED WITH ASPHALTIC MATERIAL AND WRAPPED WITH 15" ROOFING FELT.

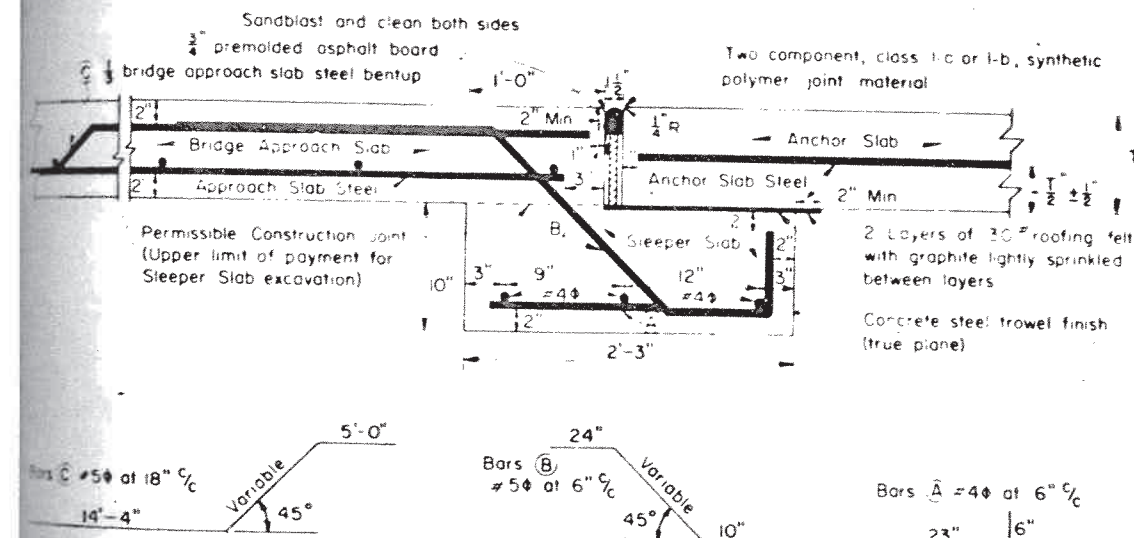


SECTION "A-A"


EXPANSION JOINT AND SLEEPER SLAB DETAIL NEW CONSTRUCTION

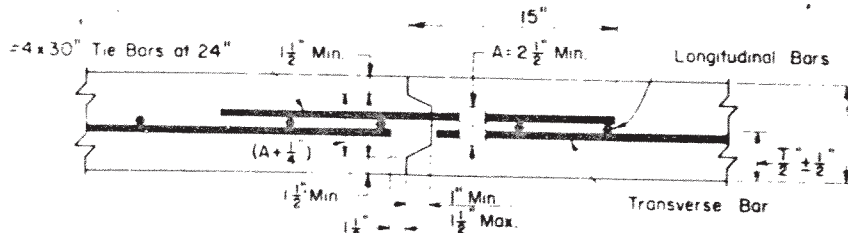


LONGITUDINAL CONSTRUCTION JOINT (Tongue and Groove with Tie Bars)

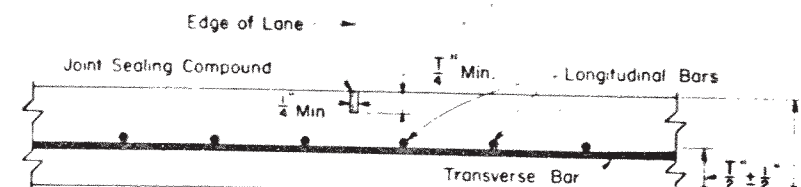

GROOVED LONGITUDINAL JOINT (Sawed or Formed)

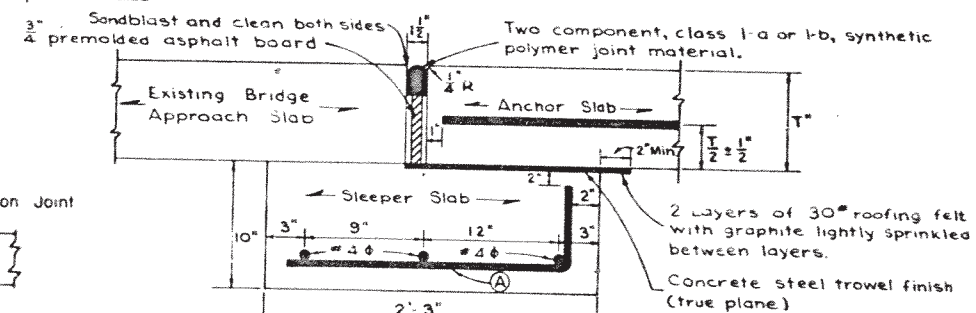

SECTION "C-C" EXPANSION JOINT AND SLEEPER SLAB DETAIL FOR EXISTING BRIDGE APPROACH SLABS

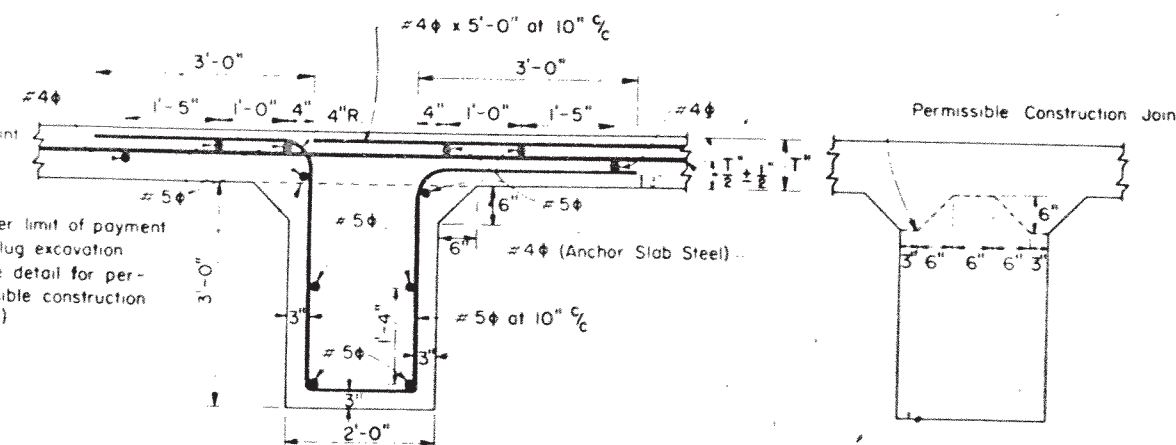

SECTION "B-B"

LUG ANCHOR DETAIL SHOWING

ESTIMATED QUANTITIES FOR ONE 24 FOOT WIDE TERMINAL ANCHORAGE

ITEM	PAVEMENT THICKNESS (IN.)	CONCRETE (CU YD)	STEEL (LBS)	EXCAVATION (CU YD)	STEEL (LBS)
SLEEPER SLAB	8	167	349	167	
	9	167	355	167	
	10	167	361	167	
ANCHORS (2)	ALL	111	1535	111	
ANCHOR SLAB	8	267*	1168	0	
	9	300*	1168	0	
	10	333*	1168	0	

\*If pavement terminus with existing flexible pavement structure, the concrete quantity should be increased by 0.2 C.Y. to include the thickened end detail.

TEXAS HIGHWAY DEPARTMENT  
TERMINAL ANCHORAGE  
FOR  
CONCRETE PAVEMENT